


Township 6 South, Range 1 East, W.M.

Section 3


RECEIVED

AUG - 6 1997

WATER RESOURCES DEPT.
SALEM, OREGON

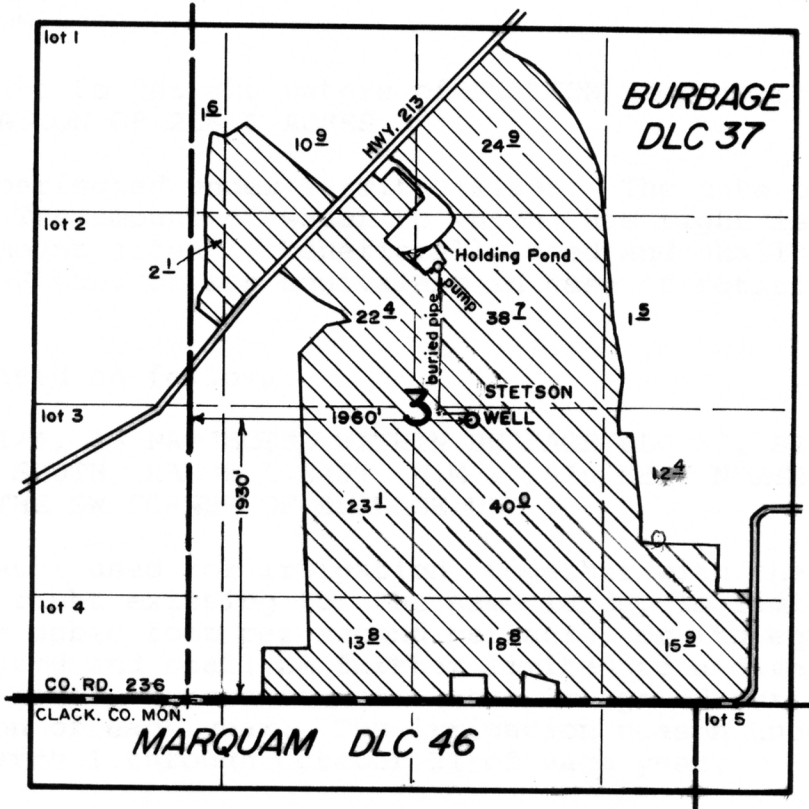

FINAL PROOF SURVEY
under
Appl. No. G-12149, Per. No. G-11688
in name of
KRAEMER FARMS
Apr. 29, 1997

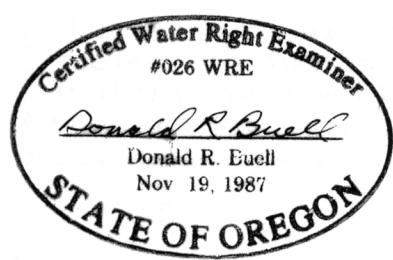

THIS MAP WAS PREPARED FOR THE PURPOSE OF IDENTIFYING THE LOCATION OF A WATER RIGHT ONLY AND IS NOT INTENDED TO PROVIDE LEGAL DIMENSIONS OR LOCATION OF PROPERTY OWNERSHIP LINES.