


# T. 3 S., R. 38 E., W.M.

SE 1/4 SE 1/4, SECTION 7

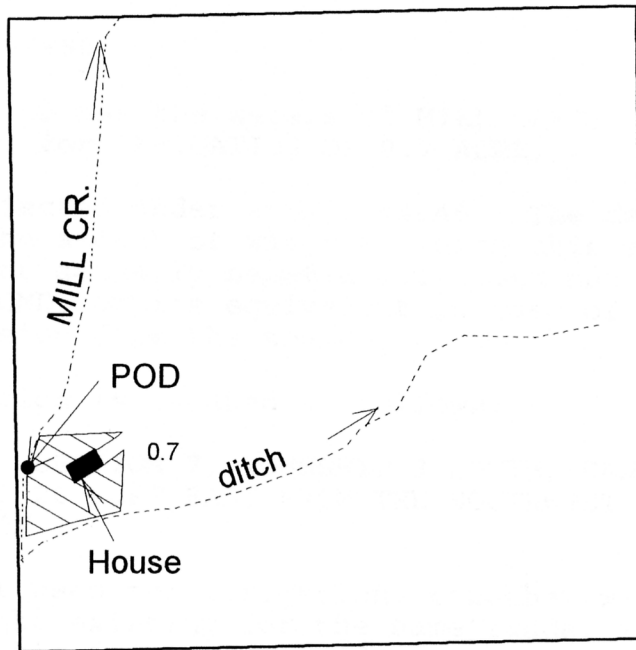

POD - 385' N. AND 20' E. FROM THE  
SW CORNER SE 1/4 SE 1/4, SECTION 7.

## FINAL PROOF SURVEY

UNDER

Application No. 58420 Permit No. 44046

IN THE NAME OF

**JOSEPH W. AND MARIE FEIK**

Surveyed 4-25-2002, by J. Miller

RECEIVED

MAY 31 2002

WATER RESOURCES DEPT.  
SALEM, OREGON

41061-179-105R JM 4-30-2002