


CLAIM OF BENEFICIAL USE
 SURVEY SEPTEMBER 16, 2001
 BY DUANE W. KIRBY
 FOR DONALD L. STEARNS
 STEARNS FAMILY TRUST
 APPLICATION NO. S-72919
 PERMIT NO. 53102
 T24S, R7W, W.M.
 SECTION 20

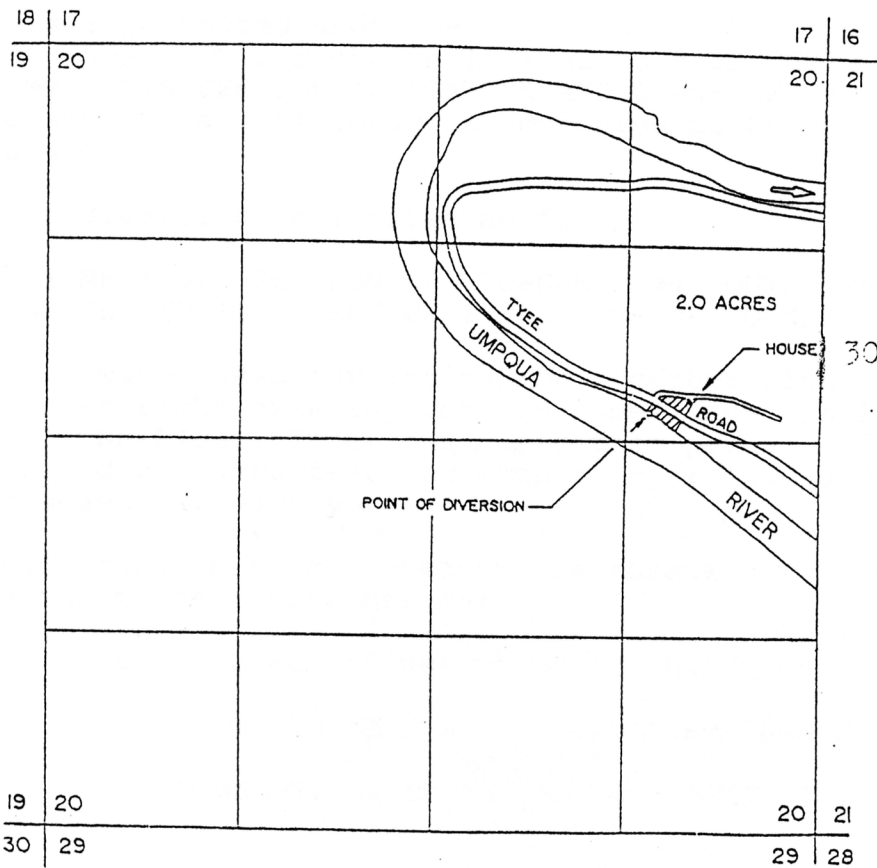

SCALE: 4" = 1 MILE

RECEIVED

SEP 20 2001

WATER RESOURCES DEPT
 SALEM, OREGON

THE POINT OF DIVERSION IS TO BE LOCATED 2460 FEET SOUTH AND 1170 FEET WEST FROM THE NORTHEAST CORNER OF SECTION 20, BEING WITHIN THE SE 1/4 OF THE NE 1/4 OF SECTION 20, TOWNSHIP 24 SOUTH, RANGE 7 WEST, W.M., DOUGLAS COUNTY.

THE PURPOSE OF THIS MAP IS TO IDENTIFY THE LOCATION OF THE WATER RIGHT. IT IS NOT INTENDED TO PROVIDE INFORMATION RELATIVE TO THE LOCATION OF PROPERTY OWNERSHIP BOUNDARY LINES.

