


CLAIM OF BENEFICIAL USE MAP FOR PERMIT R-12298 & R-12300 TO STORE WATER (H.B. 2376)

U.S.G.S. QUAD LAWRENCE CREEK, OREG. - 7 1/2'

- LEGEND**
- RESERVOIR NOT SHOWN ON QUAD
 - RESERVOIR SHOWN ON QUAD
 - ROAD
 - CHANNEL
 - FD SEC COR
 - PRIVATE PROPERTY
 - FENCE
 - TRAIL
 - BUILDING

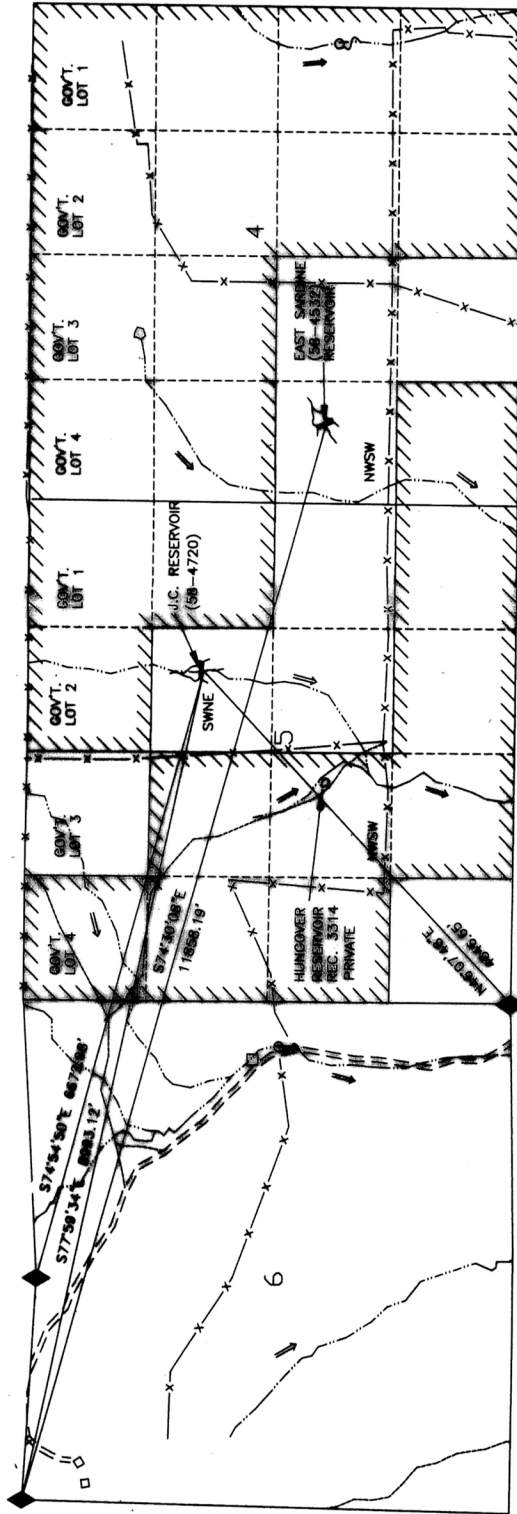

J.C. (58-4720) RESERVOIR NW1/4 NE 1/4, SEC. 5, T.10S., R.43E., W.M.
I, Thomas Terry, ADM Division of Field Services agree to the findings of the CWRE and do submit this site report and map as my Claim of Beneficial Use of the water as provided under the terms and conditions of my Permit R-12300.

EAST SARDINE (58-4532) RESERVOIR NW1/4 SW1/4, SECTION 4, T.10S., R.43E., W.M.
I, Thomas Terry, ADM Division of Field Services agree to the findings of the CWRE and do submit this site report and map as my Claim of Beneficial Use of the water as provided under the terms and conditions of my Permit R-12298

NOTE:
SECTION LINES AND CORNERS SHOWN ON THIS DRAWING WERE PREPARED FROM CORNERS LOCATED IN THE FIELD SUBSEQUENT TO THE PREPARATION OF THE 1988 LAWRENCE CREEK, OREG. - 7 1/2' U.S.G.S. QUAD.



SCALE 1"=1320'

THIS MAP IS FOR THE PURPOSE OF LOCATING A WATER RIGHT AND IS NOT INTENDED TO PROVIDE LEGAL DIMENSIONS FOR LOCATION OF PROPERTY BOUNDARIES.

ALWAYS
USE
LATEST
EDITION



Expires 12/31/02

UNITED STATES DEPARTMENT OF THE INTERIOR BUREAU OF LAND MANAGEMENT DIVISION OF OPERATIONS VALE DISTRICT	
RESERVOIRS SITUATED IN SEC 4 & 5 T.10S., R.43E., W.M.	
DESIGNED	REVIEWED
APPROVED	DATE: 10/17/00
DRAWN: CG	SCALE: 1"=1320'
SHEET 1 OF 1	DRAWING NO. JR-03-917245-1051