


CLAIM OF BENEFICIAL USE MAP

UNDER APPLICATION R-81924 ; PERMIT R-12294

NW1/4 NW1/4 SEC 27 T 7S R 41E W.M.

U.S.G.S. QUAD - KEATING NORTHWEST, OREG. - 7 1/2'

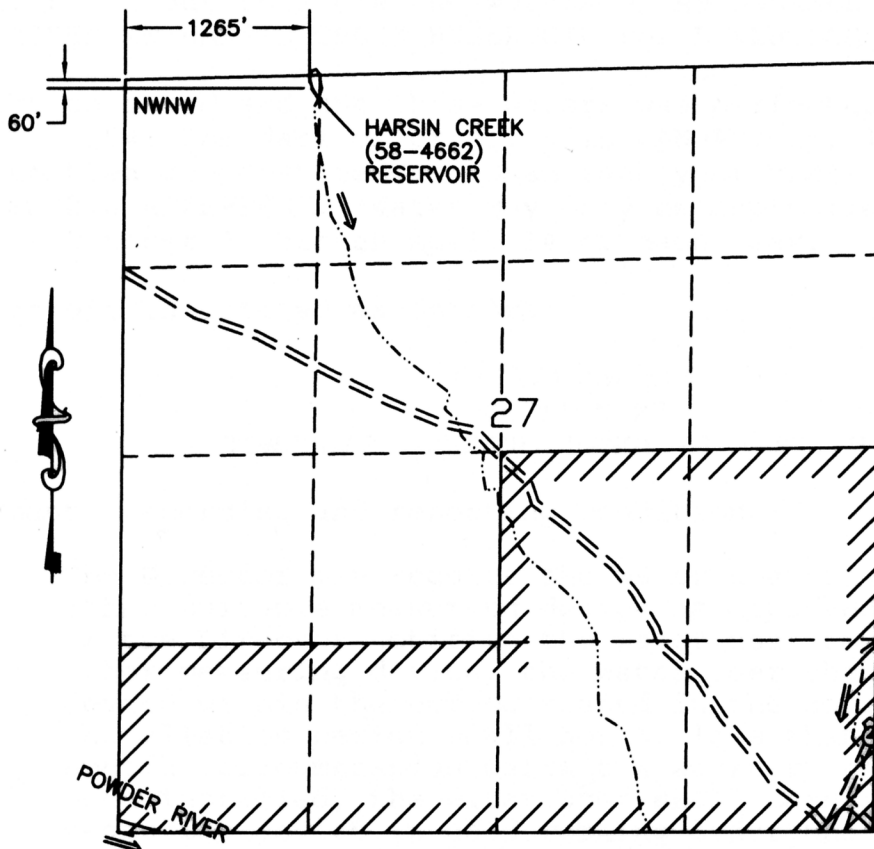

LEGEND

- RESERVOIR
- ROAD
- CHANNEL
- PRIVATE PROPERTY




RECEIVED

APR 26 2002

**WATER RESOURCES DEPT.
SALEM, OREGON**

HARSIN CREEK (58-4662) RESERVOIR

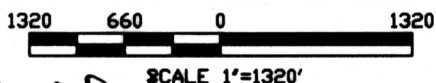

I, Thomas Terry, ADM Operations/Field Services agree to the findings of the CWRE and do submit this site report and map as my Claim of Beneficial Use of the water as provided under the terms and conditions of my Permit R-12294.



THIS MAP IS FOR THE PURPOSE OF LOCATING A WATER RIGHT AND IS NOT INTENDED TO PROVIDE LEGAL DIMENSIONS FOR LOCATION OF PROPERTY BOUNDARIES.

ACAD2000/LDD
DWG FILEHARSINCRBEN

UNITED STATES DEPARTMENT OF THE INTERIOR
BUREAU OF LAND MANAGEMENT
DIVISION OF OPERATIONS VALE DISTRICT

HARSIN CREEK
(58-4662) RESERVOIR

DRAWN BY: Vernon R. Pritchard

SURVEYED: Vernon R. Pritchard

APPROVED: Thomas Terry

ADM OPERATIONS AND FIELD SERVICES

DRAWN: CG

SCALE 1"=1320'

DATE: 11/01/01

SHEET 1 OF 1

DRAWING NO. DR-03-9172.45-1054