


CLAIM OF BENEFICIAL USE MAP FOR PERMIT R-12298 & R-12300 TO STORE WATER (H.B. 2376)

U.S.G.S. QUAD LAWRENCE CREEK, OREG. - 7 1/2'

RECEIVED

APR 20 2002
WATER RESOURCES DEPT.

- LEGEND
- RESERVOIR NOT SHOWN ON QUAD
 - RESERVOIR SHOWN ON QUAD
 - ROAD
 - CHANNEL
 - FD SEC COR
 - PRIVATE PROPERTY
 - FENCE
 - TRAIL
 - BUILDING

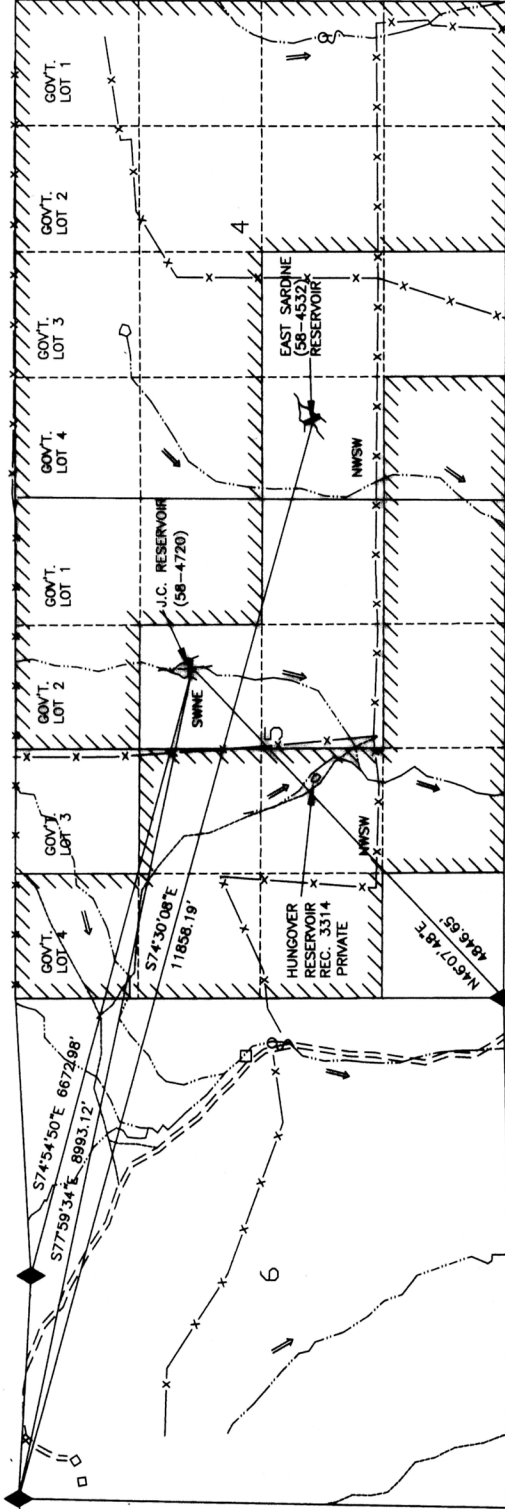

NOTE:
SECTION LINES AND CORNERS SHOWN ON THIS
DRAWING WERE PREPARED FROM CORNERS LOCATED
IN THE FIELD SUBSEQUENT TO THE PREPARATION
OF THE 1988 LAWRENCE CREEK, OREG. - 7 1/2'
U.S.G.S. QUAD.



SCALE 1"=1320'

THIS MAP IS FOR THE PURPOSE OF LOCATING
A WATER RIGHT AND IS NOT INTENDED TO
PRODUCE LEGAL BOUNDARIES FOR LOCATION
OF PROPERTY BOUNDARIES.

J.C. (58-4720) RESERVOIR SW1/4 NE 1/4, SEC. 5, T.10S., R.43E., W.M.
I, Thomas Terry, ADM Division of Field Services agree to the findings of the
CWRE and do submit this site report and map as my Claim Of Beneficial
Use of the water as provided under the terms and conditions of my
Permit R-12300.

EAST SARONIE (58-4532) RESERVOIR NW1/4 SW1/4, SECTION 4, T.10S., R.43E., W.M.
I, Thomas Terry, ADM Division of Field Services agree to the findings of the
CWRE and do submit this site report and map as my Claim Of Beneficial
Use of the water as provided under the terms and conditions of my
Permit R-12298



UNITED STATES DEPARTMENT OF THE INTERIOR BUREAU OF LAND MANAGEMENT DIVISION OF OPERATIONS VALE DISTRICT	
RESERVOIRS SITUATED IN SEC 4 & 5 T.10S., R.43E., W.M.	
DESIGNED	REVIEWED
APPROVED	APPROVED
DRAWN: CS	SCALE: 1"=1320'
DATE: 10/17/00	SHEET 1 OF 1
DRAWING NO. DR-03-9172-45-JUN	

ACAD RELEASE 11
DNG FILED W/IN RE