


CLAIM OF BENEFICIAL USE MAP

UNDER APPLICATION R-81942; PERMIT R-12253

NE1/4 SE1/4 SEC 27 T 38S R 44E W.M.

U.S.G.S. QUAD - GRASSHOPPER FLAT SOUTH, OREG. - 7 1/2'

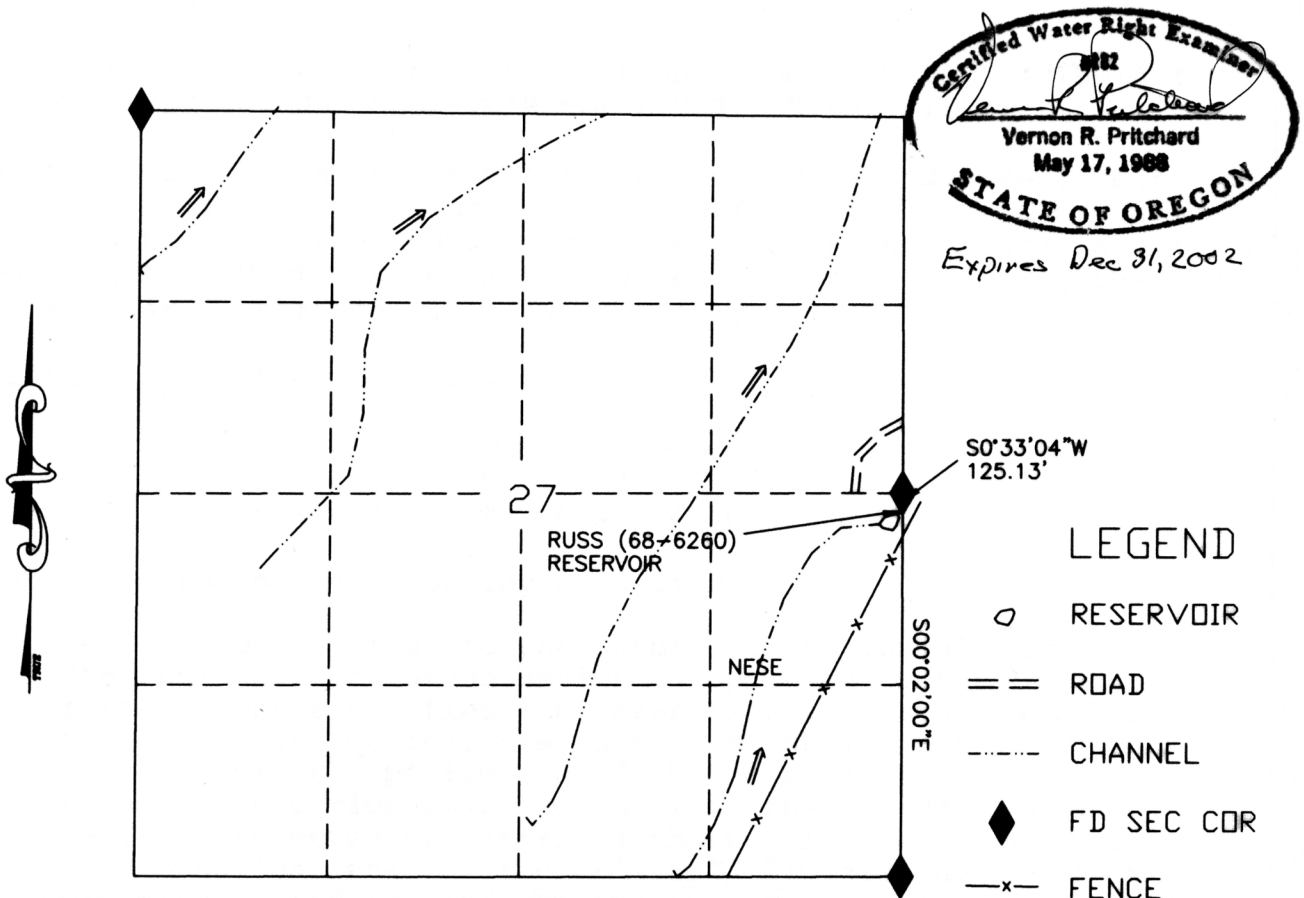

RUSS (68-6260) RESERVOIR

RECEIVED

AUG 28 2002

**WATER RESOURCES DEPT.
 SALEM, OREGON**

1320 660 0 1320
 SCALE 1"=1320'

Thomas D. Terry
 I, *Thomas D. Terry*, Acting ADM Operations/Field Services agree to the findings of the CWRE and do submit this site report and map as my Claim of Beneficial Use of the water as provided under the terms and conditions of my Permit R-12253

Thomas D. Terry



THIS MAP IS FOR THE PURPOSE OF LOCATING A WATER RIGHT AND IS NOT INTENDED TO PROVIDE LEGAL DIMENSIONS FOR LOCATION OF PROPERTY BOUNDARIES.

ACAD14
 DWG FILE: RUSSBEN

UNITED STATES DEPARTMENT OF THE INTERIOR BUREAU OF LAND MANAGEMENT DIVISION OF OPERATIONS VALE DISTRICT	
RUSS (68-6260) RESERVOIR	
DRAWN BY: <i>Thomas D. Terry</i>	
SURVEYED: <i>Thomas D. Terry</i>	
APPROVED: <i>Thomas D. Terry</i> ADM OPERATIONS AND FIELD SERVICES	
DRAWN: CG	SCALE: 1"=1320'
DATE: 10/18/00	SHEET 1 OF 1
DRAWING NO. OR-03-9172.45-1062	