


CLAIM OF BENEFICIAL USE MAP

UNDER APPLICATION R-81945; PERMIT R-12256

GOV'T LOT 3 SEC 7 T 22S R 40E W.M.

U.S.G.S. QUAD - TIMS PEAK, OREG. - 7 1/2'

RECEIVED
AUG 19 2004
WATER RESOURCES DEPT.
SALEM, OREGON

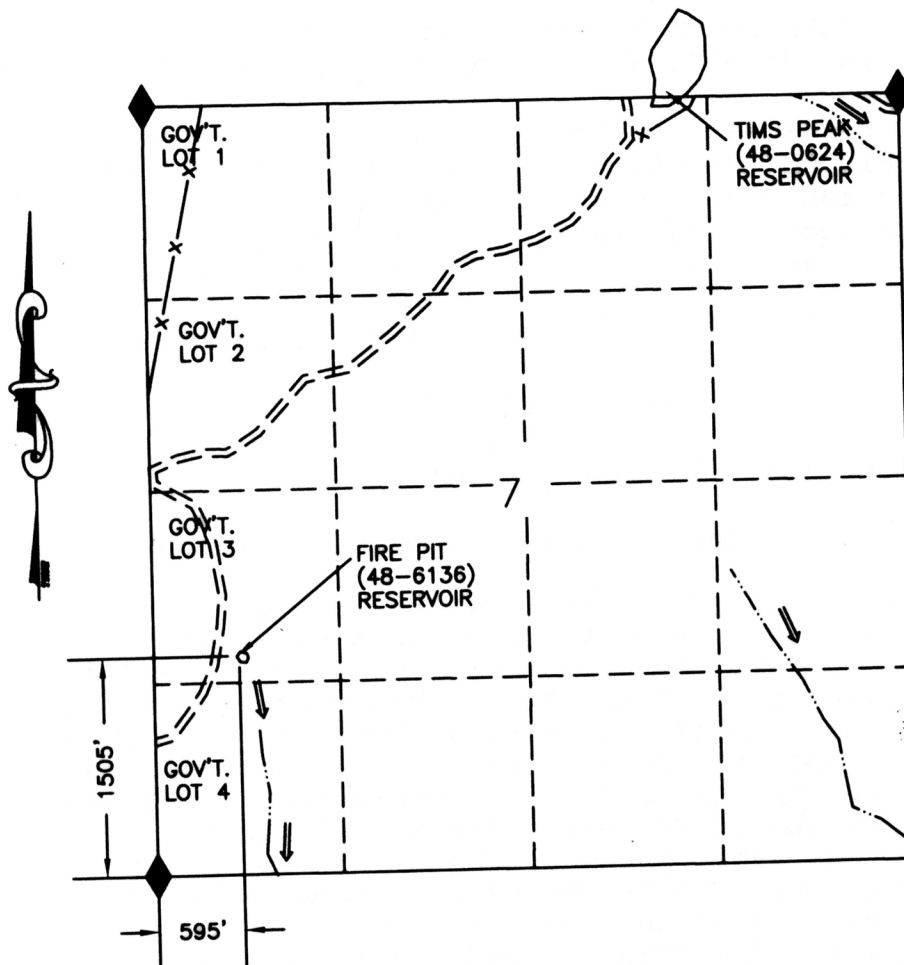

LEGEND

○ RESERVOIR

== ROAD

--- CHANNEL

◆ FD SEC COR

-x- FENCE

Certified Water Right Examiner
#182
Vernon R. Pritchard
Vernon R. Pritchard
May 17, 1988
STATE OF OREGON
Expires Dec. 31, 2002

FIRE PIT (48-6136) RESERVOIR

1320 660 0 1320
SCALE 1"=1320'

I, Thomas Terry, ADM Operations/Field Services agree to the findings of the CWRE and do submit this site report and map as my Claim of Beneficial Use of the water as provided under the terms and conditions of my Permit R-12256

Thomas Terry

THIS MAP IS FOR THE PURPOSE OF LOCATING A WATER RIGHT AND IS NOT INTENDED TO PROVIDE LEGAL DIMENSIONS FOR LOCATION OF PROPERTY BOUNDARIES.

ALWAYS
THINK
SAFETY

ACAD2000/LDD
DWG FILE: firepit.dwg

UNITED STATES DEPARTMENT OF THE INTERIOR BUREAU OF LAND MANAGEMENT DIVISION OF OPERATIONS VALE DISTRICT	
FIRE PIT (48-6136) RESERVOIR	
DRAWN BY: <i>Vernon R. Pritchard</i>	
SURVEYED: <i>Vernon R. Pritchard</i>	
APPROVED: <i>Vernon R. Pritchard</i>	
ADM OPERATIONS AND FIELD SERVICES	
DRAWN: CG	SCALE: 1"=1320'
DATE: 10/31/01	SHEET 1 OF 1
DRAWING NO. OR-03-9172.45-1052	