
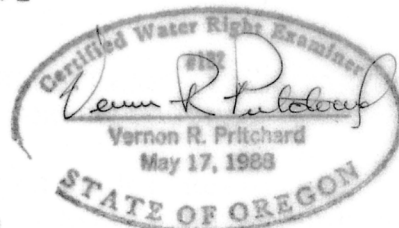


CLAIM OF BENEFICIAL USE MAP

UNDER APPLICATION R-82501; PERMIT R-12282

NE1/4NW1/4 SEC 15 T 17S R 36E W.M.

U.S.G.S. QUAD - BUCK TROUGH SPRING, OREG. - 7 1/2'

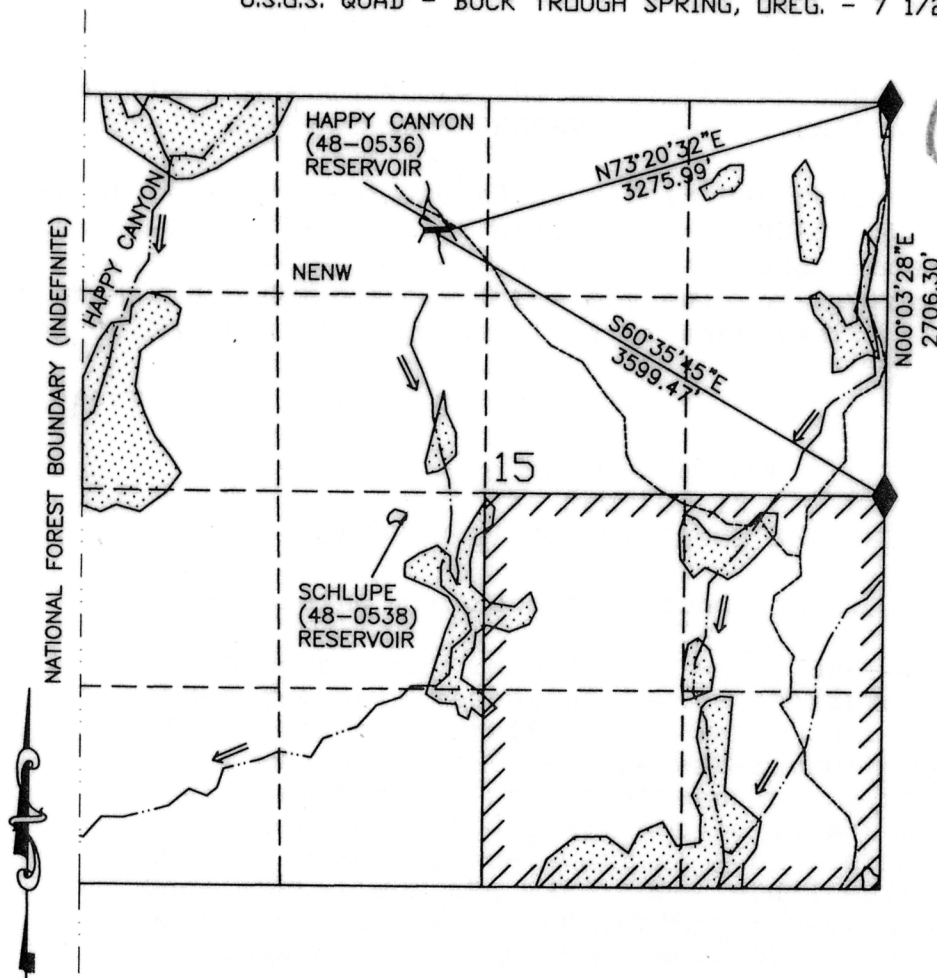

Expires Dec. 31, 2002

LEGEND

- RESERVOIR SHOWN ON QUAD
- RESERVOIR NOT SHOWN ON QUAD
- TRAIL
- CHANNEL
- FD SEC COR
- NATIONAL FOREST BOUNDARY
- TREE AREA
- PRIVATE PROP.

HAPPY CANYON (48-0536) RESERVOIR

1320 660 0 1320
SCALE 1"=1320'

I, Thomas Terry, ADM Operations/Field Services agree to the findings of the CWRE and do submit this site report and map as my Claim of Beneficial Use of the water as provided under the terms and conditions of my Permit R-12282

Thomas Terry

THIS MAP IS FOR THE PURPOSE OF LOCATING A WATER RIGHT AND IS NOT INTENDED TO PROVIDE LEGAL DIMENSIONS FOR LOCATION OF PROPERTY BOUNDARIES.



ACAD2000/LDD
DWG FILEHAPPYCANBEN

UNITED STATES DEPARTMENT OF THE INTERIOR
BUREAU OF LAND MANAGEMENT
DIVISION OF OPERATIONS VALE DISTRICT

HAPPY CANYON (48-0536) RESERVOIR

DRAWN BY: *Vernon R. Pritchard*
SURVEYED: *Vernon R. Pritchard*
APPROVED: *Thomas Terry*
ADM OPERATIONS AND FIELD SERVICES
DRAWN: CG SCALE: 1"=1320'
DATE: 10/31/01 SHEET 1 OF 1
DRAWING NO. OR-03-9172.45-1053