


CLAIM OF BENEFICIAL USE MAP


UNDER APPLICATION R-82509; PERMIT R-12266

SE1/4 NW1/4 SEC 5 T 17S R 39E W.M.

U.S.G.S. QUAD - LITTLE JUNIPER SPRING, OREG. - 7 1/2'

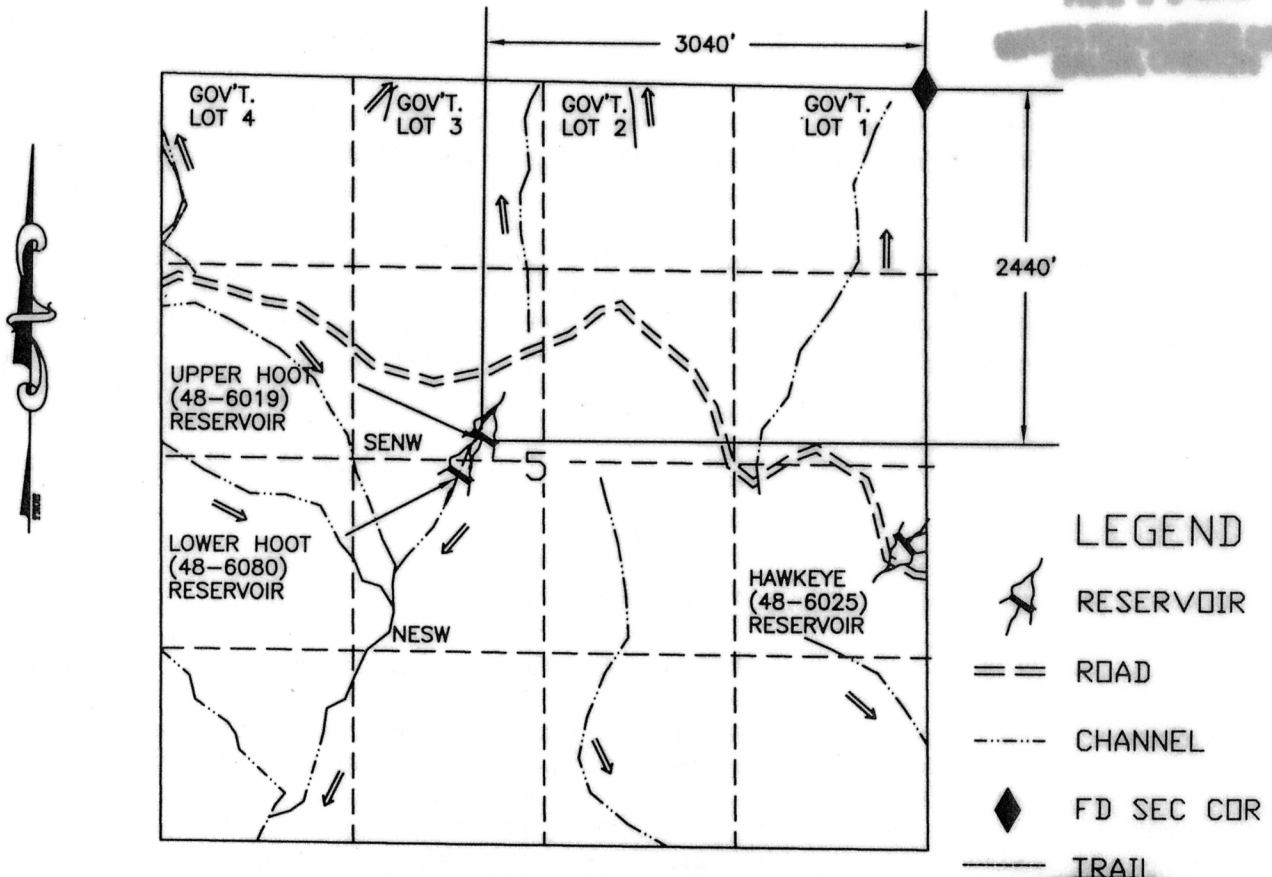

UPPER HOOT (48-6019) RESERVOIR

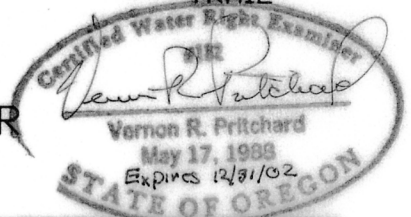

1320 660 0 1320
SCALE 1"=1320'

I, Thomas Terry, ADM Operations/Field Services agree to the findings of the CWRE and do submit this site report and map as my Claim of Beneficial Use of the water as provided under the terms and conditions of my Permit R-12266

Thomas Terry



THIS MAP IS FOR THE PURPOSE OF LOCATING A WATER RIGHT AND IS NOT INTENDED TO PROVIDE LEGAL DIMENSIONS FOR LOCATION OF PROPERTY BOUNDARIES.

ACAD2000/LDD
DWG FILE: UHOOTBEN

UNITED STATES DEPARTMENT OF THE INTERIOR
BUREAU OF LAND MANAGEMENT
DIVISION OF OPERATIONS VALE DISTRICT

UPPER HOOT
(48-6019) RESERVOIR

DRAWN BY: *Vernon R. Pritchard*
SURVEYED: *Vernon R. Pritchard*
APPROVED: *Thomas Terry*
ADM OPERATIONS AND FIELD SERVICES

DRAWN: CG SCALE: 1"=1320'
DATE: 11/01/01 SHEET 1 OF 1
DRAWING NO. OR-03-9172.45-1093