


CLAIM OF BENEFICIAL USE MAP

UNDER APPLICATION R-82510; PERMIT R-12267

NW1.4 NE1.4 SEC 28 T 22S R 39E W.M.

U.S.G.S. QUAD - MONUMENT PEAK, OREG. - 7 1/2'

RECEIVED
AUG 28 1988
WATER RESOURCES DIV
BUREAU OF LAND MANAGEMENT

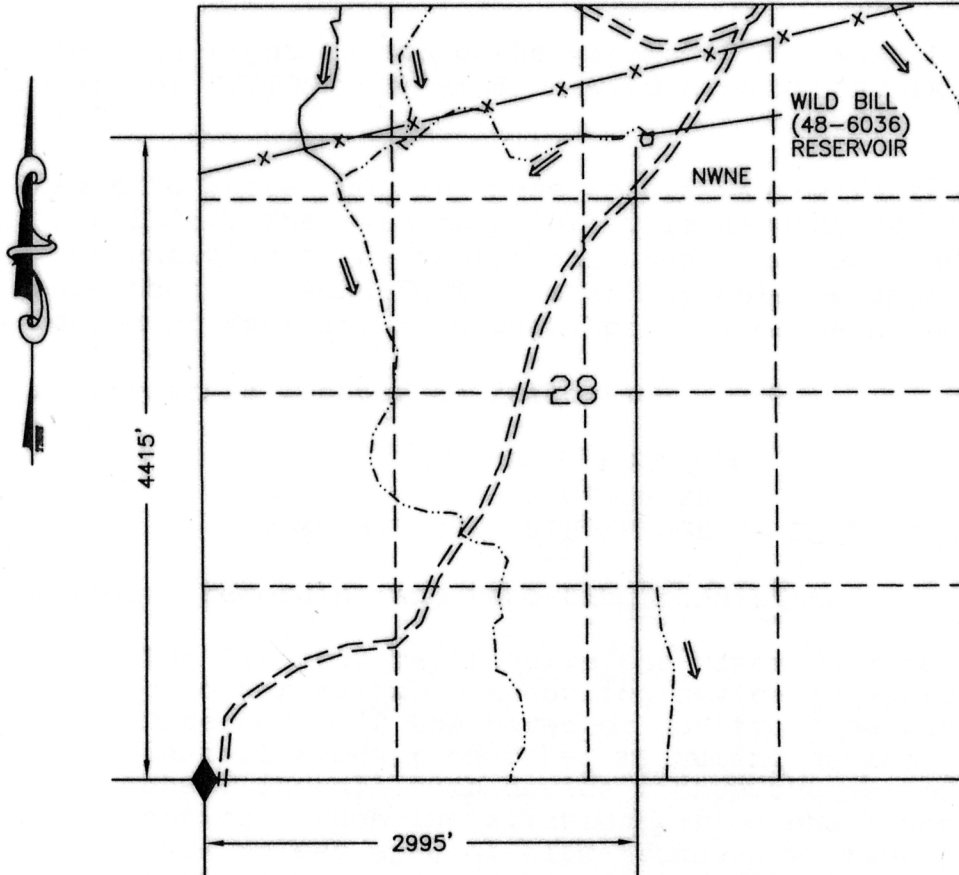

LEGEND


◇ RESERVOIR

== ROAD

--- CHANNEL

◆ FD SEC COR

—x— FENCE

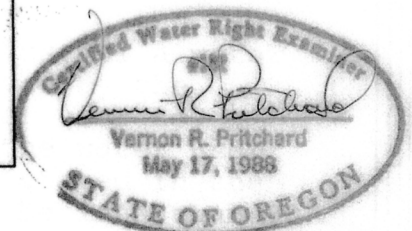

Expires Dec 31, 2002

WILD BILL (48-6036) RESERVOIR

1320 660 0 1320
SCALE 1"=1320'

I, Thomas Terry, ADM Operations/Field Services agree to the findings of the CWRE and do submit this site report and map as my Claim of Beneficial Use of the water as provided under the terms and conditions of my Permit R-12267

Thomas Terry

THIS MAP IS FOR THE PURPOSE OF LOCATING A WATER RIGHT AND IS NOT INTENDED TO PROVIDE LEGAL DIMENSIONS FOR LOCATION OF PROPERTY BOUNDARIES.



ACAD2000/LDD
DWG FILE: WILDBILL.BEN

UNITED STATES DEPARTMENT OF THE INTERIOR
BUREAU OF LAND MANAGEMENT
DIVISION OF OPERATIONS VALE DISTRICT

WILD BILL (48-6036)
RESERVOIR

DRAWN BY: *Thomas Terry*

SURVEYED: *Thomas Terry*

APPROVED: *Thomas Terry*

ADM OPERATIONS AND FIELD SERVICES

DRAWN: CG

SCALE: 1"=1320'

DATE: 11/01/01

SHEET 1 OF 1

DRAWING NO. OR-03-9172.45-1094