


# CLAIM OF BENEFICIAL USE MAP

UNDER APPLICATION R-82517; PERMIT R-12273

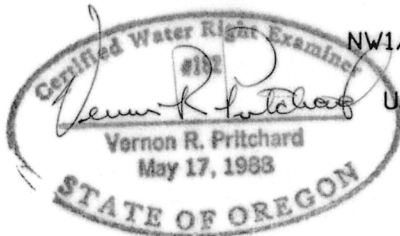


NW1/4 NE1/4 SEC 24 T 10S R 42E W.M.

U.S.G.S. QUAD - OXMAN, OREG. 7 1/2'


Expires Dec 31, 2002

## LEGEND

- RESERVOIR
- == ROAD
- - - CHANNEL
- ◆ FD SEC COR
- x- FENCE

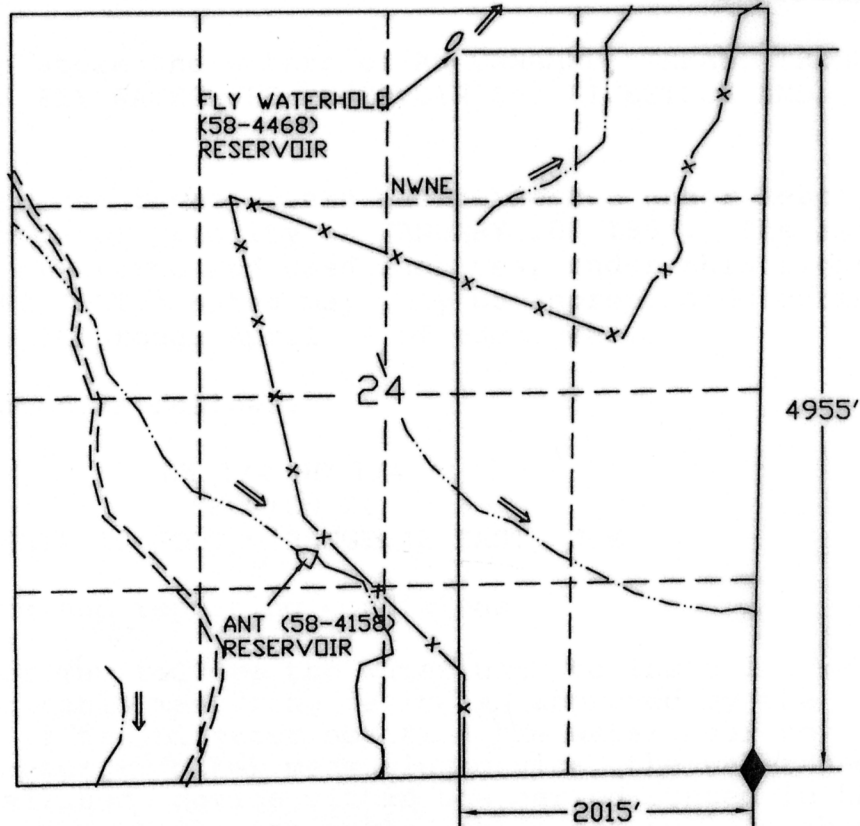

FLY WATERHOLE (58-4468) RESERVOIR

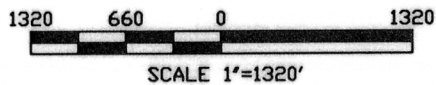

I, Thomas Terry, ADM Operations/Field Services agree to the findings of the CWRE and do submit this site report and map as my Claim of Beneficial Use of the water as provided under the terms and conditions of my Permit R-12273.

*Thomas Terry*



THIS MAP IS FOR THE PURPOSE OF LOCATING A WATER RIGHT AND IS NOT INTENDED TO PROVIDE LEGAL DIMENSIONS FOR LOCATION OF PROPERTY BOUNDARIES.

ACAD2000/LDD  
DWG FILE: FLYWHBEN

UNITED STATES DEPARTMENT OF THE INTERIOR  
BUREAU OF LAND MANAGEMENT  
DIVISION OF OPERATIONS VALE DISTRICT

## FLY WATERHOLE (58-4468) RESERVOIR

DRAWN BY: *Vernon R. Pritchard*  
SURVEYED: *Vernon R. Pritchard*  
APPROVED: *Thomas Terry*  
ADM OPERATIONS AND FIELD SERVICES

DRAWN: CG SCALE: 1"=1320'

DATE: 10/31/01 SHEET 1 OF 1

DRAWING NO. OR-03-9172.45-1081