

# CLAIM OF BENEFICIAL USE MAP

UNDER APPLICATION R-82518; PERMIT R-12274


GOV'T LOT 3 SEC 30 T 9S R 43E W.M.

U.S.G.S. QUAD - GLASGOW BUTTE, OREG. - 7 1/2'

RECEIVED


AIR 20 2002

WATER RESOURCES DEPT.  
SALEM, OREGON

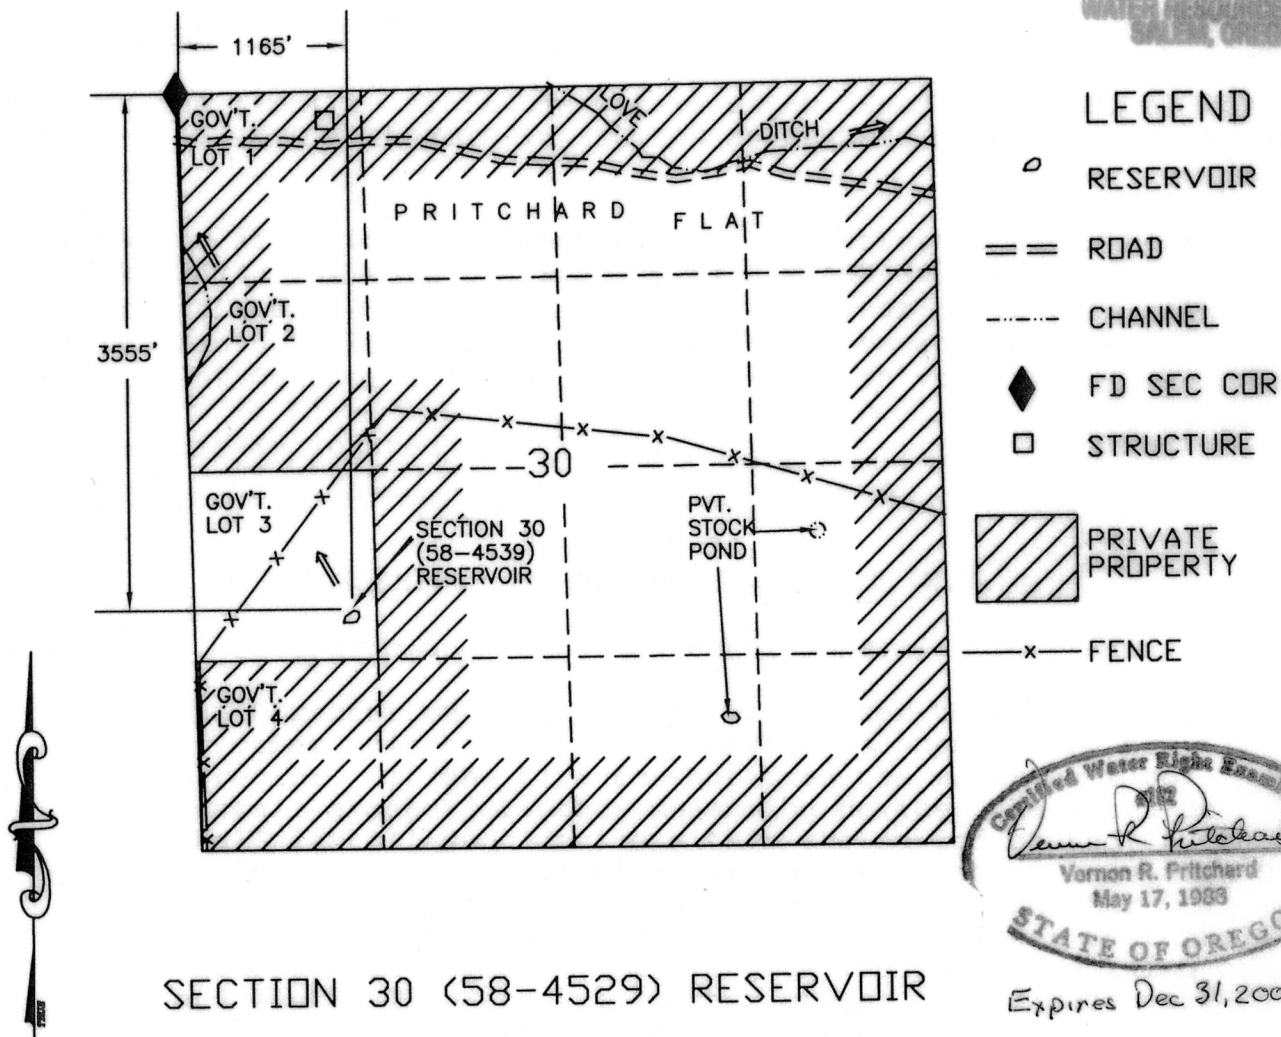

## LEGEND

- RESERVOIR
- == ROAD
- CHANNEL
- ◆ FD SEC COR
- STRUCTURE
- ▨ PRIVATE PROPERTY
- x- FENCE

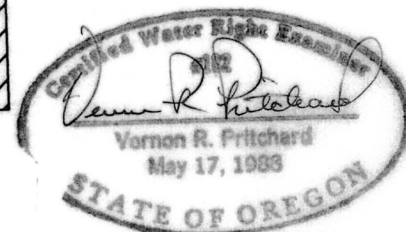

SECTION 30 (58-4529) RESERVOIR

Expires Dec 31, 2002

1320 660 0 1320  
SCALE 1"=1320'

I, Thomas Terry, ADM Operations/Field Services agree to the findings of the CWRE and do submit this site report and map as my Claim of Beneficial Use of the water as provided under the terms and conditions of my Permit R-12274.

*Thomas Terry*



THIS MAP IS FOR THE PURPOSE OF LOCATING A WATER RIGHT AND IS NOT INTENDED TO PROVIDE LEGAL DIMENSIONS FOR LOCATION OF PROPERTY BOUNDARIES.

ACAD 2000/LDD  
DWG FILE:SECTN30BEN

UNITED STATES DEPARTMENT OF THE INTERIOR  
BUREAU OF LAND MANAGEMENT  
DIVISION OF OPERATIONS VALE DISTRICT

SECTION 30 (58-4539)  
RESERVOIR

DRAWN BY: *Vernon R. Pritchard*  
SURVEYED: *Thomas Terry*  
APPROVED: *Thomas Terry*  
ADM OPERATIONS AND FIELD SERVICES

DRAWN: CG SCALE: 1"=1320'

DATE: 11/01/01 SHEET 1 OF 1

DRAWING NO. OR-03-9172.45-1091