


CLAIM OF BENEFICIAL USE MAP

UNDER APPLICATION R-82523; PERMIT R-12279

SW 1/4 SEC 33, T.37S., R.43E., W.M.
U.S.G.S. QUAD - BATTLE MOUNTAIN, OREG. - 7 1/2"

RECEIVED
NOV 11 1999

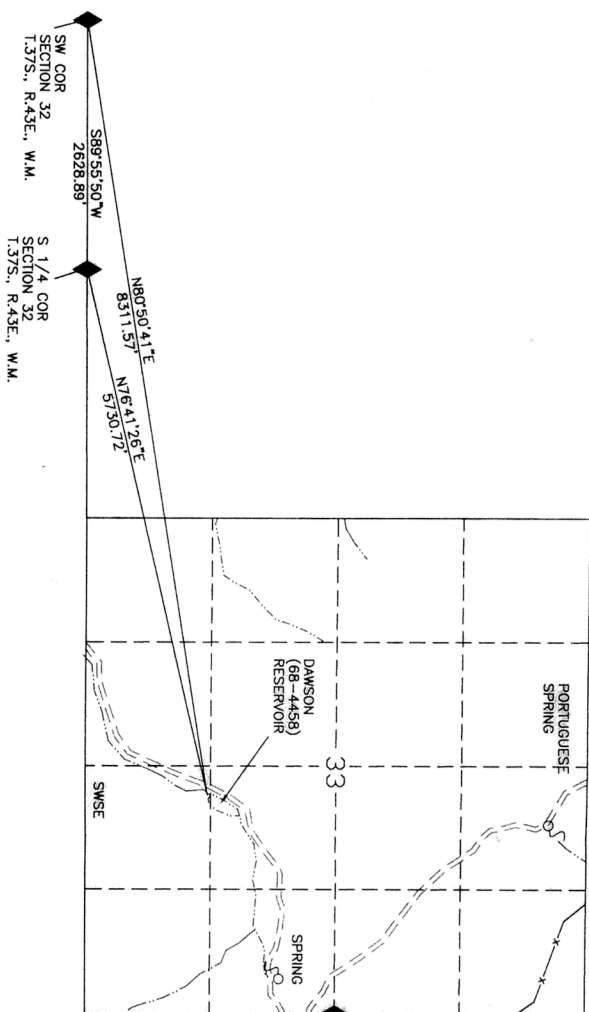

- LEGEND
- RESERVOIR
 - ROAD
 - CHANNEL
 - FD SEC CDR
 - FENCE
 - SPRING



1320 660 0 1320
SCALE 1"=1320'

THIS MAP IS FOR THE PURPOSE OF LOCATING
A WATER RIGHT AND NOT TO PROVIDE
LEGAL DIMENSIONS FOR LOCATION
OF PROPERTY BOUNDARIES.

I, Thomas Terry, ADM Division of Field Services
agree to the findings of the GWR and do submit
this site report and map as my Claim of Beneficial
Use of the water as provided under the terms and
conditions of my Permit R-12279



ADD RELEASE 11
DWS FILED IN 11/2/00

UNITED STATES DEPARTMENT OF THE INTERIOR	
BUREAU OF LAND MANAGEMENT	
DIVISION OF OPERATIONS VALE DISTRICT	
DAWSON (68-4458)	
RESERVOIR	
DESIGNED	
REVIEWED	
APPROVED	
DRAWN	CG
DATE	11/02/00
DRAWING NO.	OR-03-917245-1078
SHEET 1 OF 1	