


CLAIM OF BENEFICIAL USE MAP

UNDER APPLICATION R-83415; PERMIT R-12343

SE1/4 NW1/4 SEC 1 T 19S R 36E W.M.

U.S.G.S. QUAD - BEULAH, OREG. - 7 1/2'

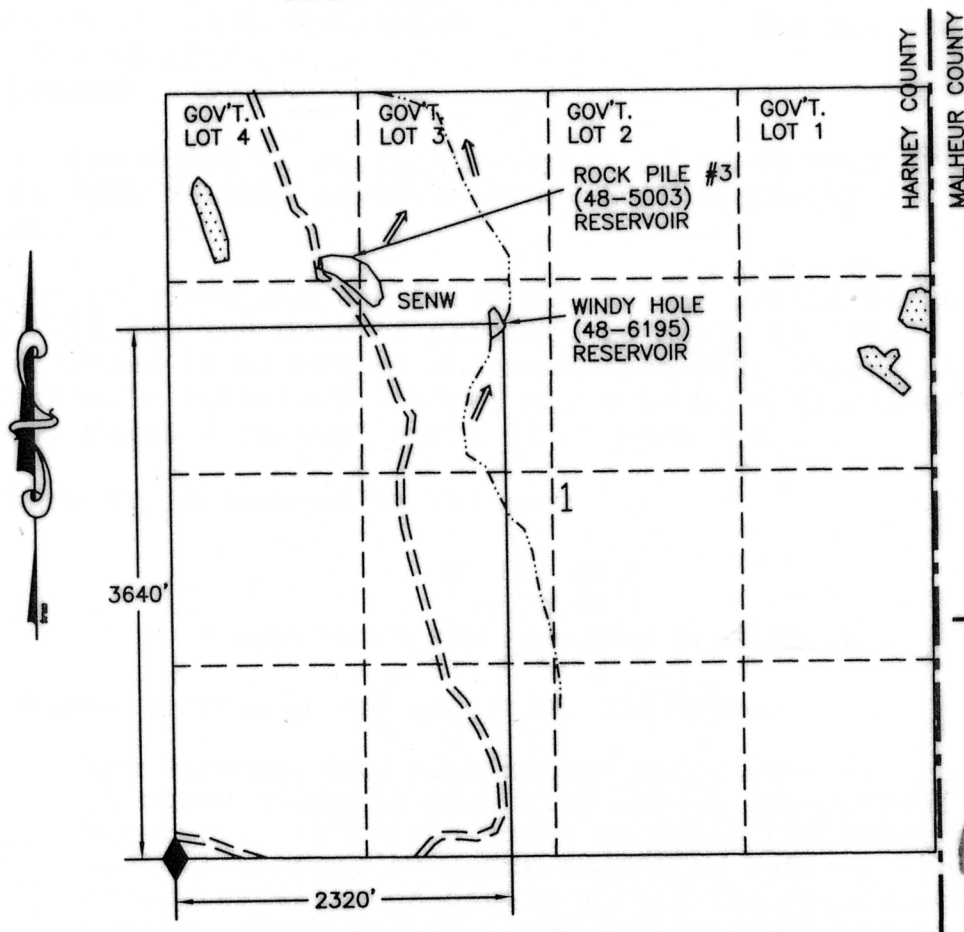

RECEIVED
AUG 28 1988
BUREAU OF LAND MANAGEMENT

LEGEND

- RESERVOIR
- ROAD
- CHANNEL
- FD SEC COR
- COUNTY LINE
- TREE AREA

Certified Water Right Examiner
Vernon R. Pritchard
Vernon R. Pritchard
May 17, 1988
STATE OF OREGON

Expires Dec 31, 2002

WINDY HOLE (48-6195) RESERVOIR

1320 660 0 1320
SCALE 1"=1320'

I, Thomas Terry, ADM Operations/Field Services agree to the findings of the CWRE and do submit this site report and map as my Claim of Beneficial Use of the water as provided under the terms and conditions of my Permit R-12343

Thomas Terry

THIS MAP IS FOR THE PURPOSE OF LOCATING A WATER RIGHT AND IS NOT INTENDED TO PROVIDE LEGAL DIMENSIONS FOR LOCATION OF PROPERTY BOUNDARIES.

ACAD2000/LDD
DWG FILE WINDYHOLBEN



UNITED STATES DEPARTMENT OF THE INTERIOR BUREAU OF LAND MANAGEMENT DIVISION OF OPERATIONS VALE DISTRICT	
WINDY HOLE (48-6195) RESERVOIR	
DRAWN BY: <i>Vernon R. Pritchard</i>	
SURVEYED: <i>Vernon R. Pritchard</i>	
APPROVED: <i>Thomas Terry</i> ADM OPERATIONS AND FIELD SERVICES	
DRAWN: CG	SCALE: 1"=1320'
DATE: 11/01/01	SHEET 1 OF 1
DRAWING NO. OR-03-9172.45-1065	