


MAP
 Accompanying Application
 for
 Permit to Appropriate Water


Rhea Luper State Engr
 scale 2 in = 1 mi -

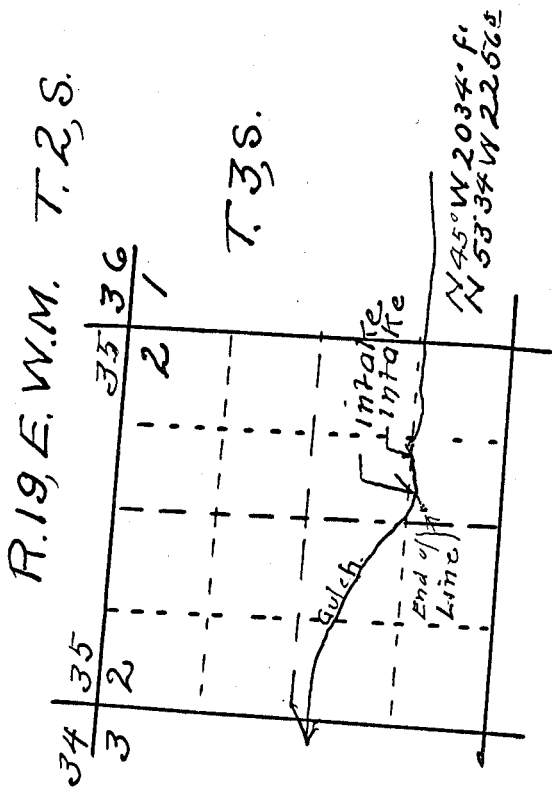

Certificate of Registered Professional
 - Engineer -

I, R. A. Dean of Condon Oregon do hereby
 certify that this map was made from
 notes taken during an actual survey
 made by me on Dec 7-1928 and
 that it correctly represents the works
 described in the accompanying ap-
 plication together with the location
 of streams and other ditches in
 the immediate vicinity

R. A. Dean
 Reg. Prof. Engineer
 Ore No 138
 Nov 8 1919

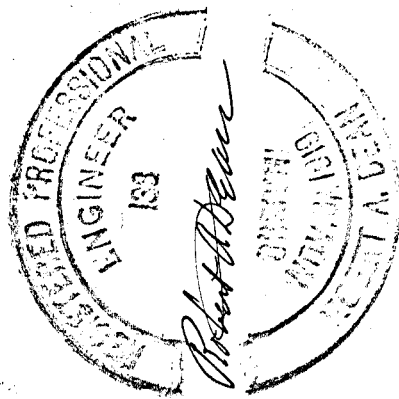

Application No. 13408
 8823
 Permit No.

P. 8823
 7975