


T. 9 S. R. 39 E. W. M.

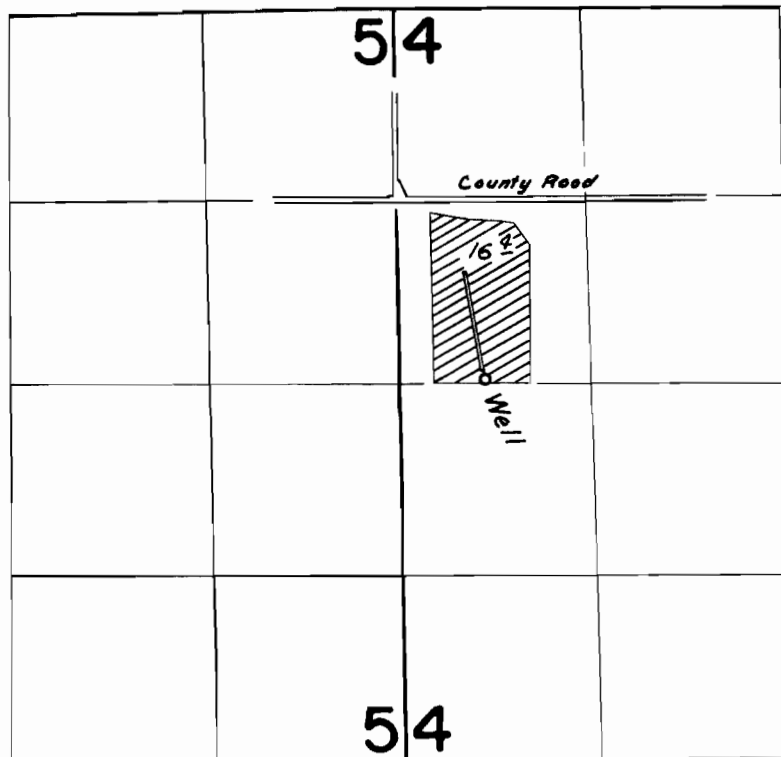

FINAL PROOF SURVEY
UNDER

Application No. G-1527 Permit No. G-1403
IN NAME OF

BERT BRINK

Surveyed Nov. 16, 1964, by C. J. Gardner