


T. 1 N. R. 32 E. W. M.

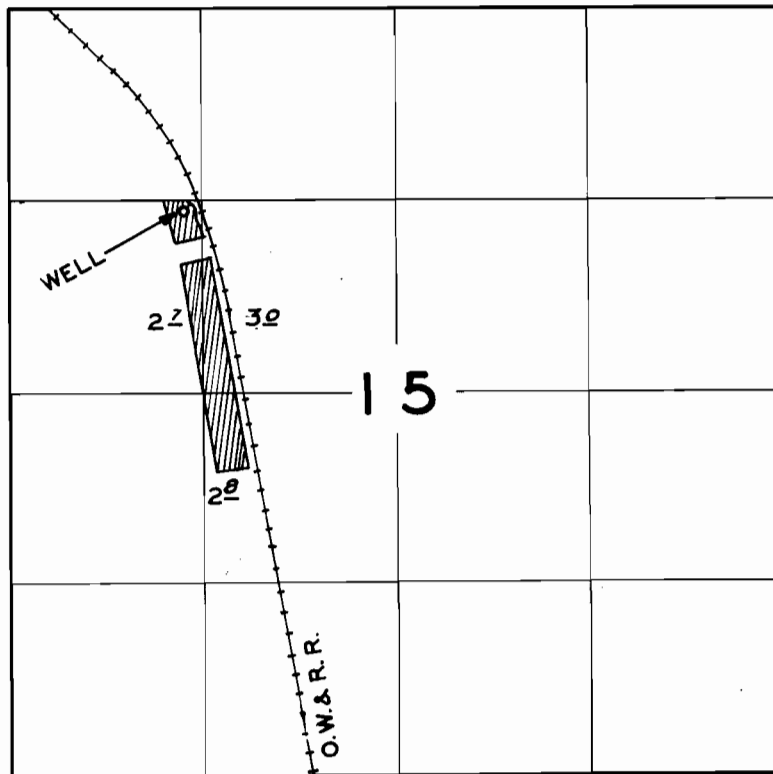

FINAL PROOF SURVEY
UNDER

Application No. G262 Permit No. G185
IN NAME OF

WILLIAM ELDRIDGE

Surveyed JULY 12 1960, by *Johnson*