


T.6N.R.35E.W.M.

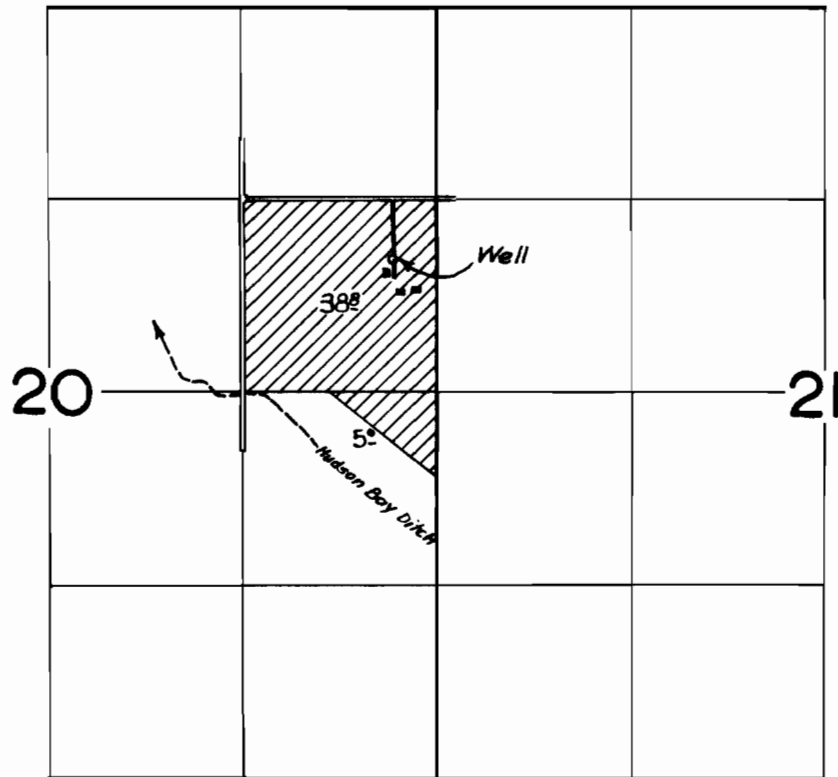

**FINAL PROOF SURVEY**  
UNDER

Application No. **G-1378**... Permit No. **G-1217**...  
IN NAME OF

**MRS. R. H. HOODENPYLE**

Surveyed April 25, 1962., by *A. Jackson*