

187
1961

RECEIVED
MAY 21 1963

UNITED STATES
DEPARTMENT OF THE INTERIOR
BUREAU OF LAND MANAGEMENT

SECTION 21
STATE ENGINEER


Oregon State Water Filings

RECEIVED

AUG 12 2002

TOWNSHIP 10S, RANGE 42E, W. M.

WATER RESOURCES DEPT.
SALEM, OREGON

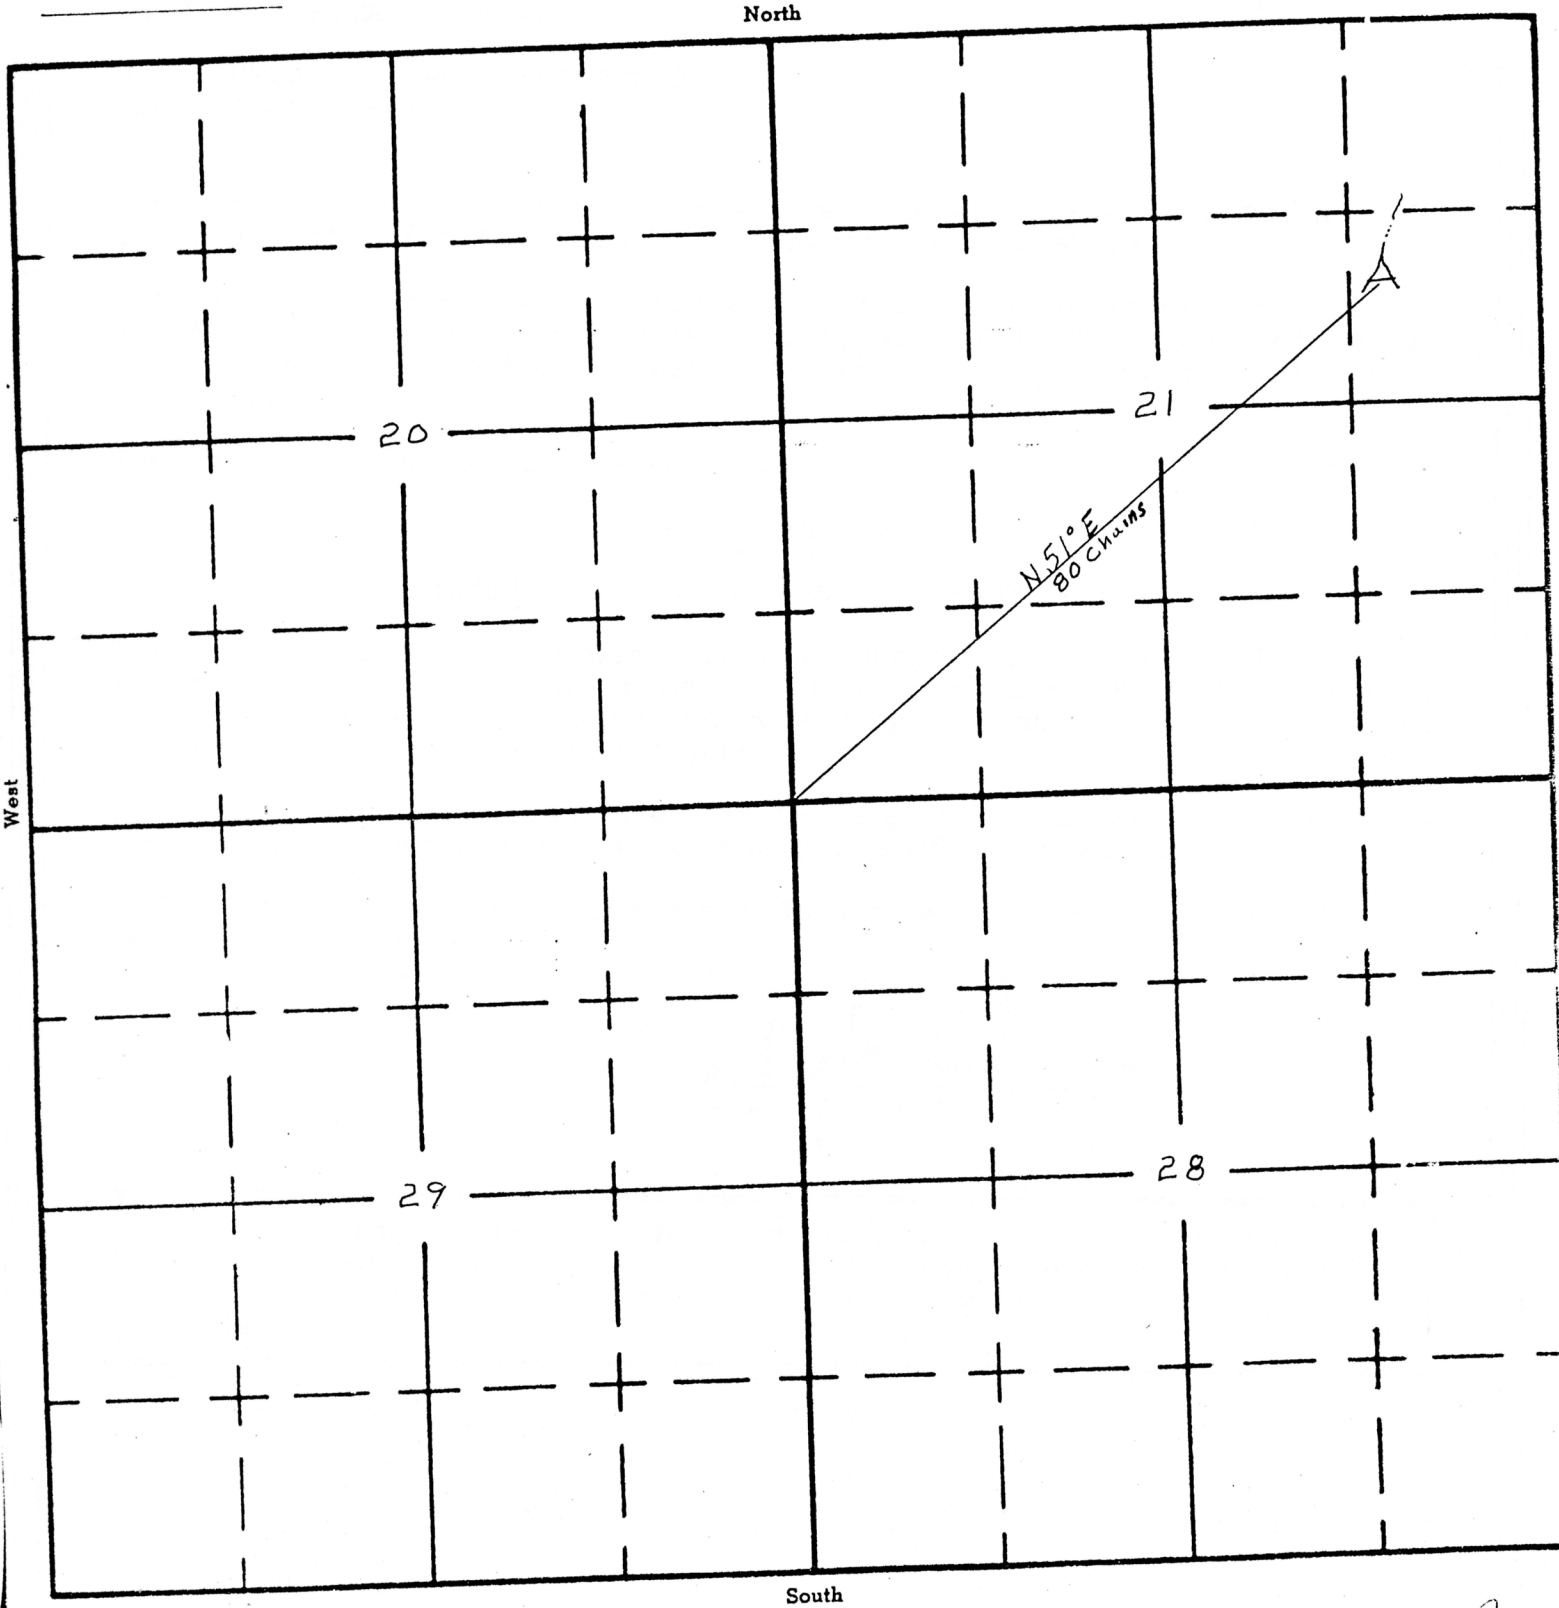

APPLICATION No. R-383
PERMIT No. R-326