

RECEIVED

DEC 10 2002


WATER RESOURCES
SALEM, OREGON

CLAIM OF BENEFICIAL USE MAP


UNDER APPLICATION R-81930; PERMIT R-12369

NW1/4 SE1/4 SEC 23 T 38S R 40E W.M.

U.S.G.S. QUAD - BLUE MOUNTAIN BASIN, OREG. - 7 1/2'

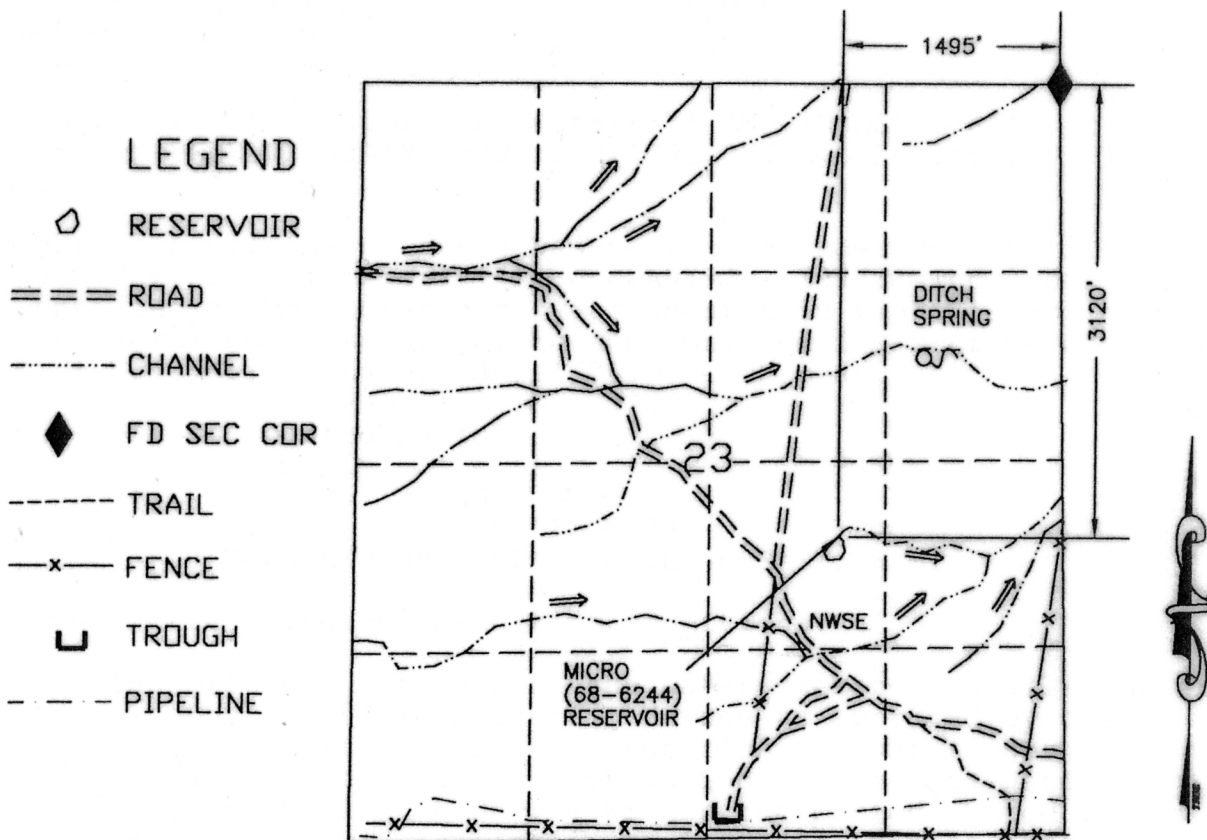

MICRO (68-6244) RESERVOIR

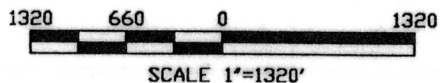

I, Thomas Terry ADM Operations/Field Services agree to the findings of the CWRE and do submit this site report and map as my Claim of Beneficial Use of the water as provided under the terms and conditions of my Permit R-12369

Thomas Terry

THIS MAP IS FOR THE PURPOSE OF LOCATING A WATER RIGHT AND IS NOT INTENDED TO PROVIDE LEGAL DIMENSIONS FOR LOCATION OF PROPERTY BOUNDARIES.



UNITED STATES DEPARTMENT OF THE INTERIOR BUREAU OF LAND MANAGEMENT DIVISION OF OPERATIONS VALE DISTRICT	
MICRO (68-6244) RESERVOIR	
DRAWN BY: <i>Thomas Terry</i>	
SURVEYED: <i>Thomas Terry</i>	
APPROVED: <i>Thomas Terry</i> ADM OPERATIONS AND FIELD SERVICES	
DRAWN: CG	SCALE: 1"=1320'
DATE: 11/02/01	SHEET 1 OF 1
DRAWING NO. OR-03-9172.45-1106	

ACAD2000/LDD
DWG FILE: MICROPITBEN