


T. 7S. R. 1E. W.M.

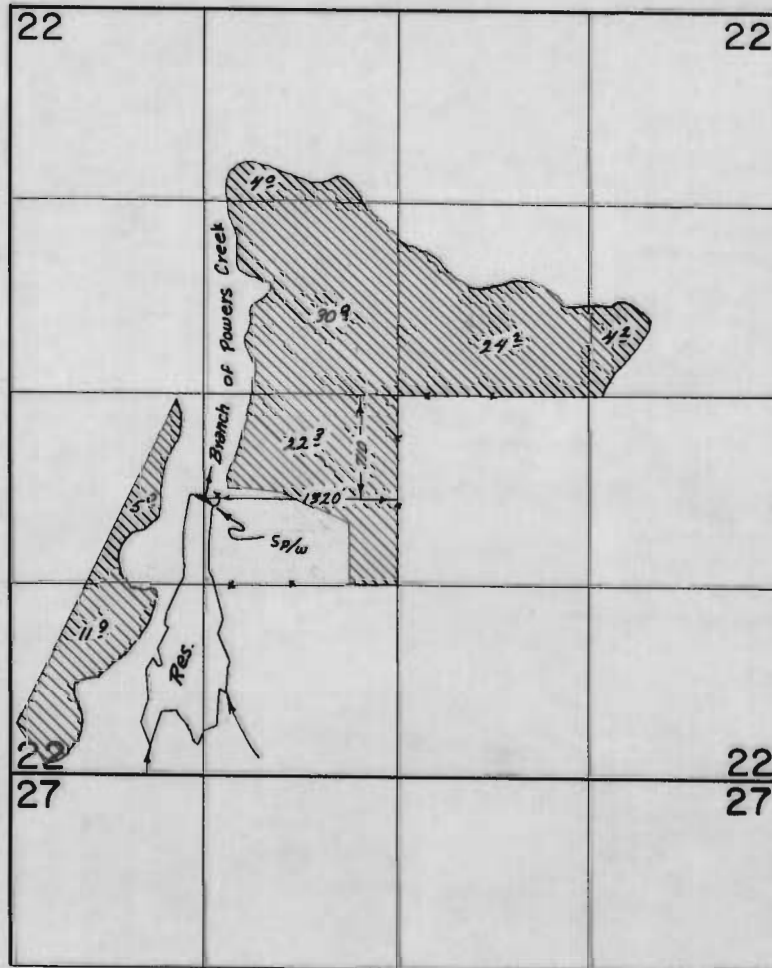


FINAL PROOF SURVEY
UNDER

Application No. R-48107 48108 Permit No. R-5849 58126
IN NAME OF

ROBERT F. DeSANTIS

Surveyed June 25 1979, by R.A. Mucken

T.7 S. R.1 E. W.M.

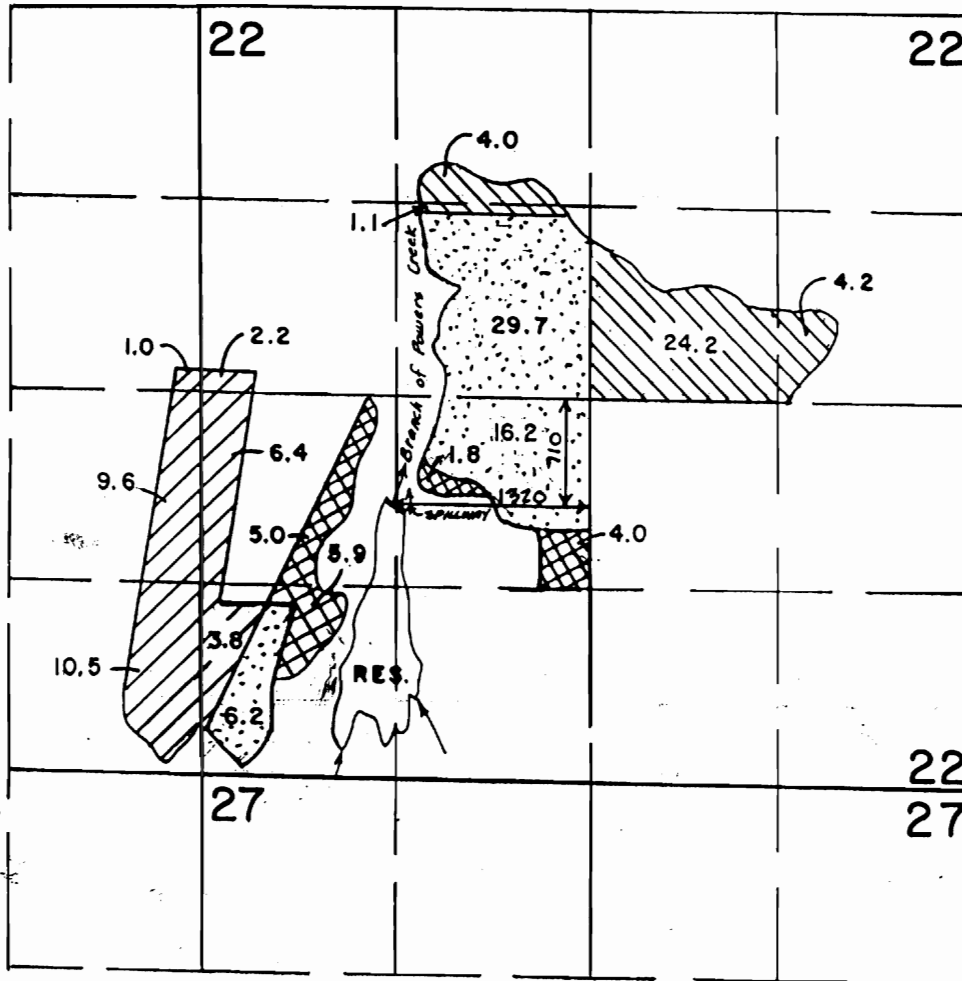

-  TO
-  FROM
-  REMAINING ACRES
-  FORFEITED ACRES

WATER RIGHT MAP FOR

ROBERT De SANTIS

SURVEYED ON SEPT. 6, 1991

T-6657

RECEIVED

DEC 20 1991

WATER RIGHTS DIVISION
SPRING, OREGON

THIS MAP WAS PREPARED FOR THE
PURPOSE OF IDENTIFYING THE LOCALITY
OF A WATER RIGHT ONLY AND IS
NOT INTENDED TO PROVIDE LEGAL
ADVICE OR DETERMINATION OF PROPER
PROPERTY LINES.