


T.2N., R., 42E. W.M

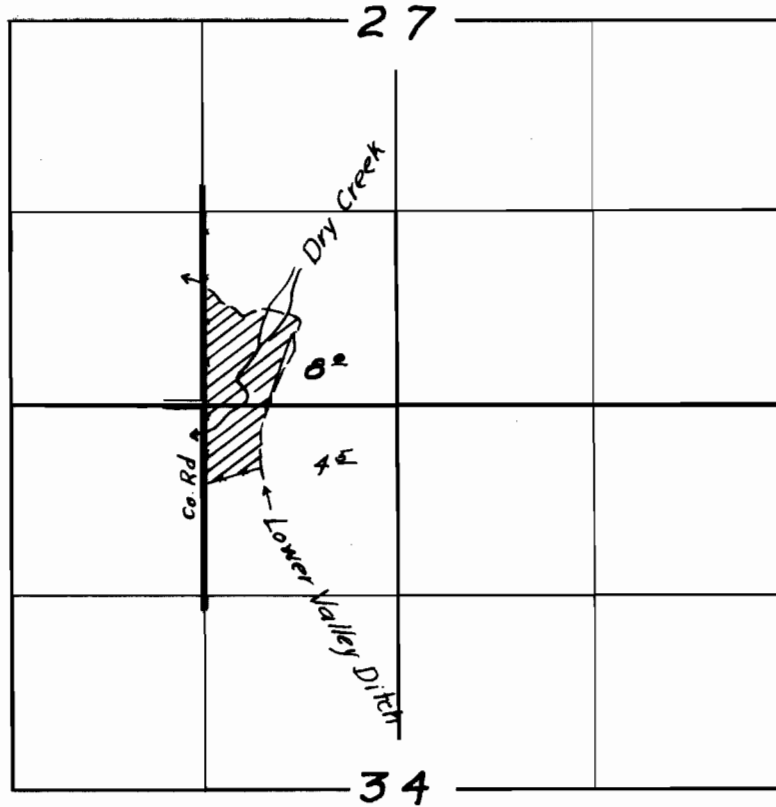

FINAL PROOF SURVEY
UNDER

Application No. 22147 Permit No. 17440
IN NAME OF

Dewey Mercer & Millie Mercer

Surveyed 22 October 1955, by Robert H. Beck