
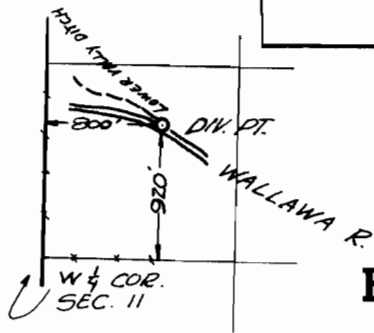


# T. 1 N. R. 42 E. W.M.

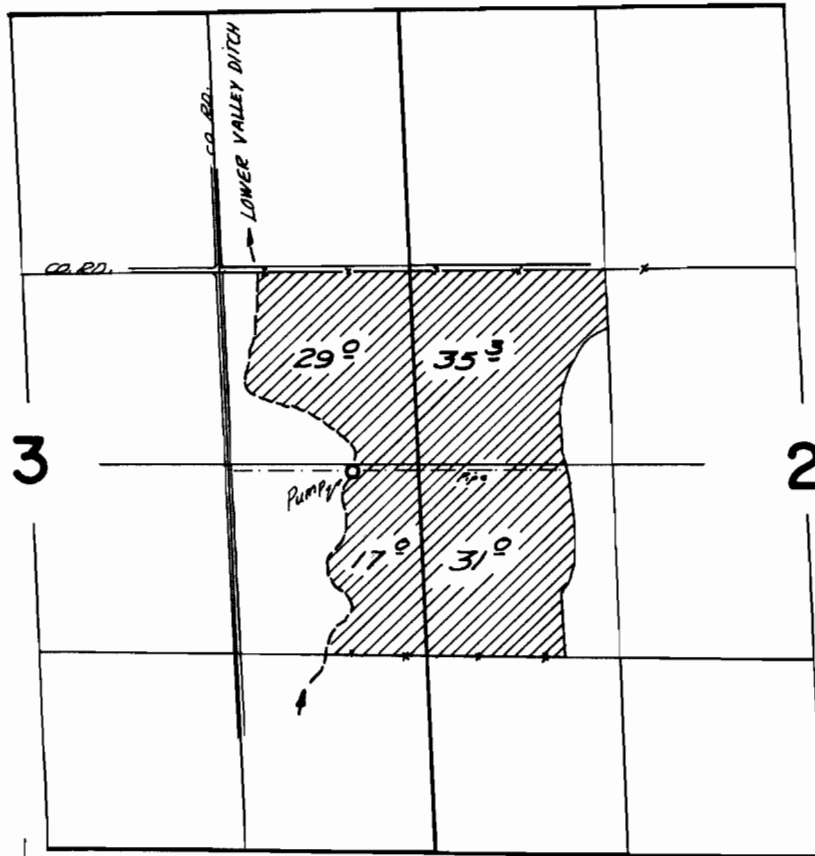

## FINAL PROOF SURVEY UNDER

Application No. 39163 Permit No. 29134  
IN NAME OF

M. CRAWFORD OVESON

Surveyed June 23 1966, by V. GARNER  
Aug. 3 1966