


TOWNSHIP 1 NORTH, RANGE 42 EAST, W.M.

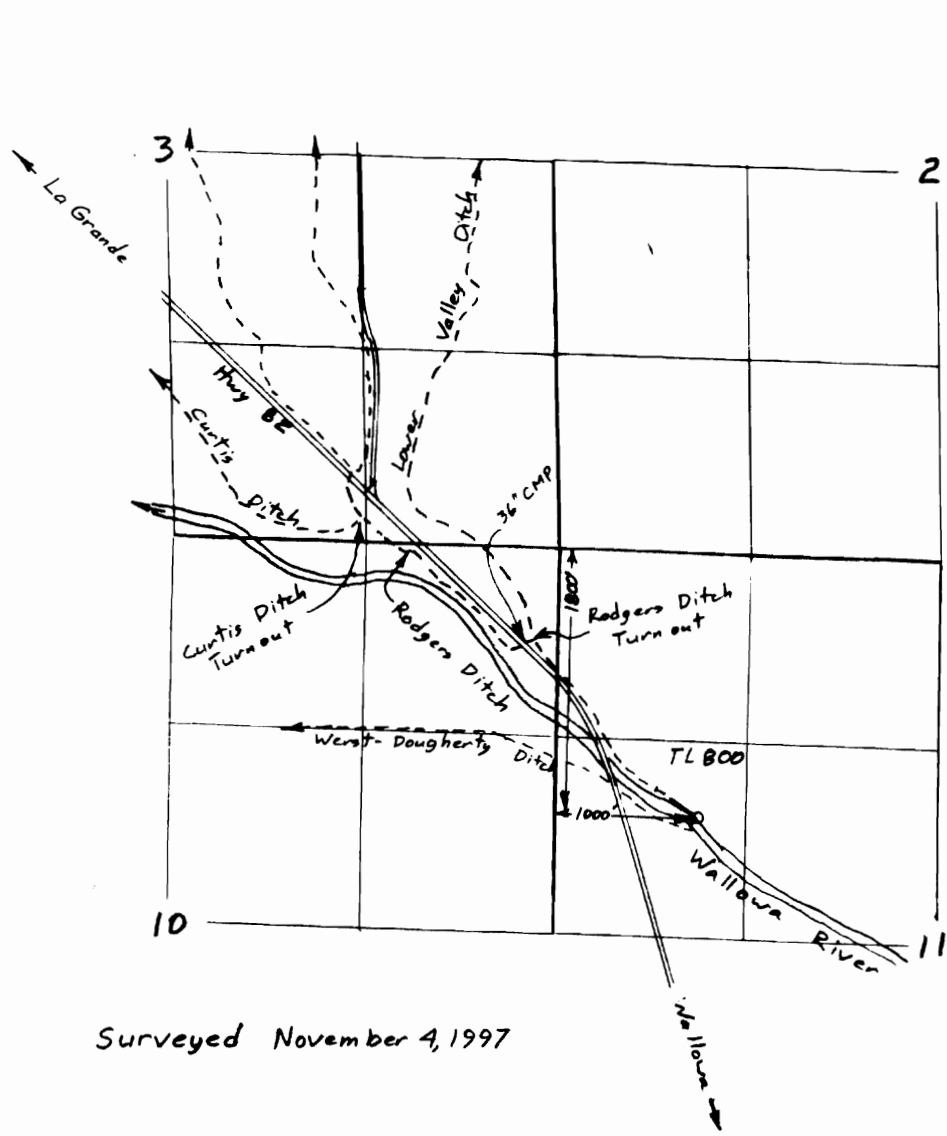

Scale 1" = 1320'

Surveyed November 4, 1997

RECEIVED


FEB 09 1998

WATER RESOURCES DEPT
SALEM OREGON

T-7489

Claim of Beneficial Use Map
for

LOWER VALLEY WATER IMPROVEMENT DIST.

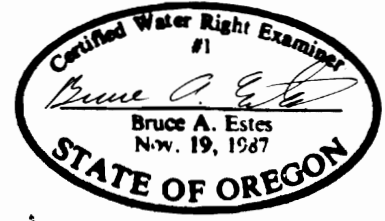

This map is for the purpose of locating a water right only and has no intent to provide legal dimensions or the location of property lines.

ESTES SURVEYS
 6293 Sunnyview Rd. NE 60382 Arnold Rd.
 Salem, OR 97305 Bend, OR 97702
 (503) 585-7593 (503) 382-7391