


# WATER RIGHT MAP FOR LOCATION CHANGE

NE1/4 SW1/4 SEC 10 T 25S R 45E W.M.

U.S.G.S. QUAD THREE FINGERS ROCK, OREG. - 7 1/2'

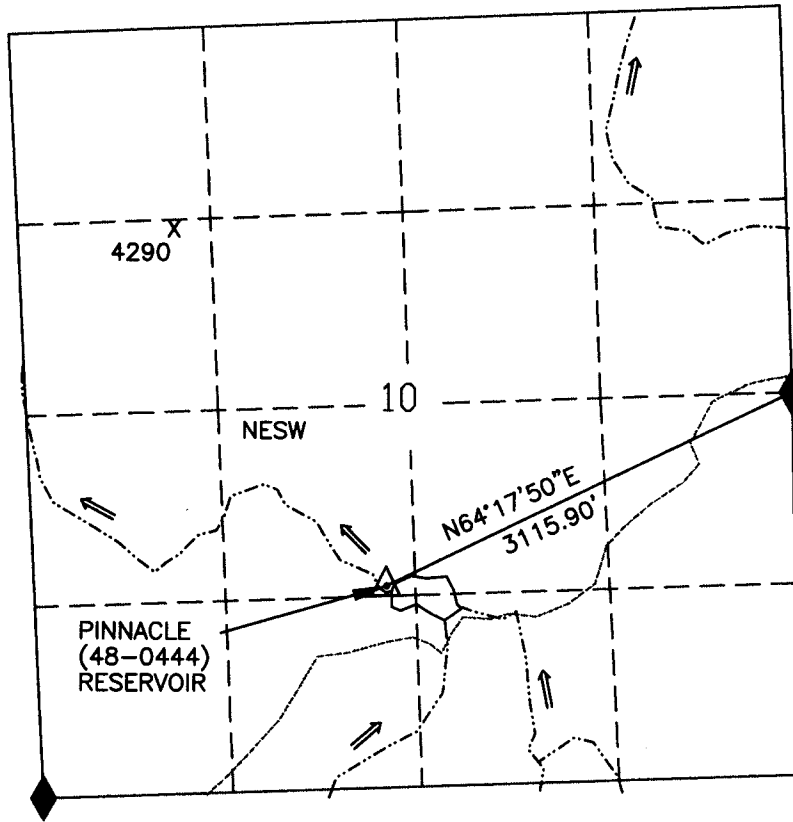

## LEGEND


- RESERVOIR
- JEEP TRAIL
- CHANNEL
- FD SEC COR
- PROJECT MON.
- ELEVATION

**RECEIVED**

DEC 04 2002

WATER RESOURCES DEPT.  
SALEM, OREGON

PINNACLE (48-0444) RESERVOIR

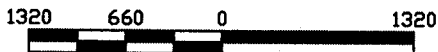

SCALE 1"=1320'

THIS MAP IS FOR THE PURPOSE OF LOCATING  
A WATER RIGHT AND IS NOT INTENDED TO  
PROVIDE LEGAL DIMENSIONS FOR LOCATION  
OF PROPERTY BOUNDARIES.



ACAD20001  
DWG FILE: PINNACLE-LOC-CHANGE

UNITED STATES DEPARTMENT OF THE INTERIOR  
BUREAU OF LAND MANAGEMENT  
DIVISION OF OPERATIONS VALE DISTRICT

PINNACLE (48-0444)  
RESERVOIR

DESIGNED \_\_\_\_\_

REVIEWED *John J. Hall*

APPROVED *Thomas J. Perry*

CHIEF, BRANCH OF ENGINEERING

DRAWN: CG

SCALE: 1"=1320'

DATE: 11/12/02

SHEET 1 OF 1

DRAWING NO.

OR-03-9172.45-1163