

Al-187
March 1961

UNITED STATES
DEPARTMENT OF THE INTERIOR
BUREAU OF LAND MANAGEMENT


SECTION

Oregon State Water Filings

35

TOWNSHIP 21S, RANGE 38E, W. M.

*Dugout
Upper ~~South~~ Creek ~~Quarry~~ North*

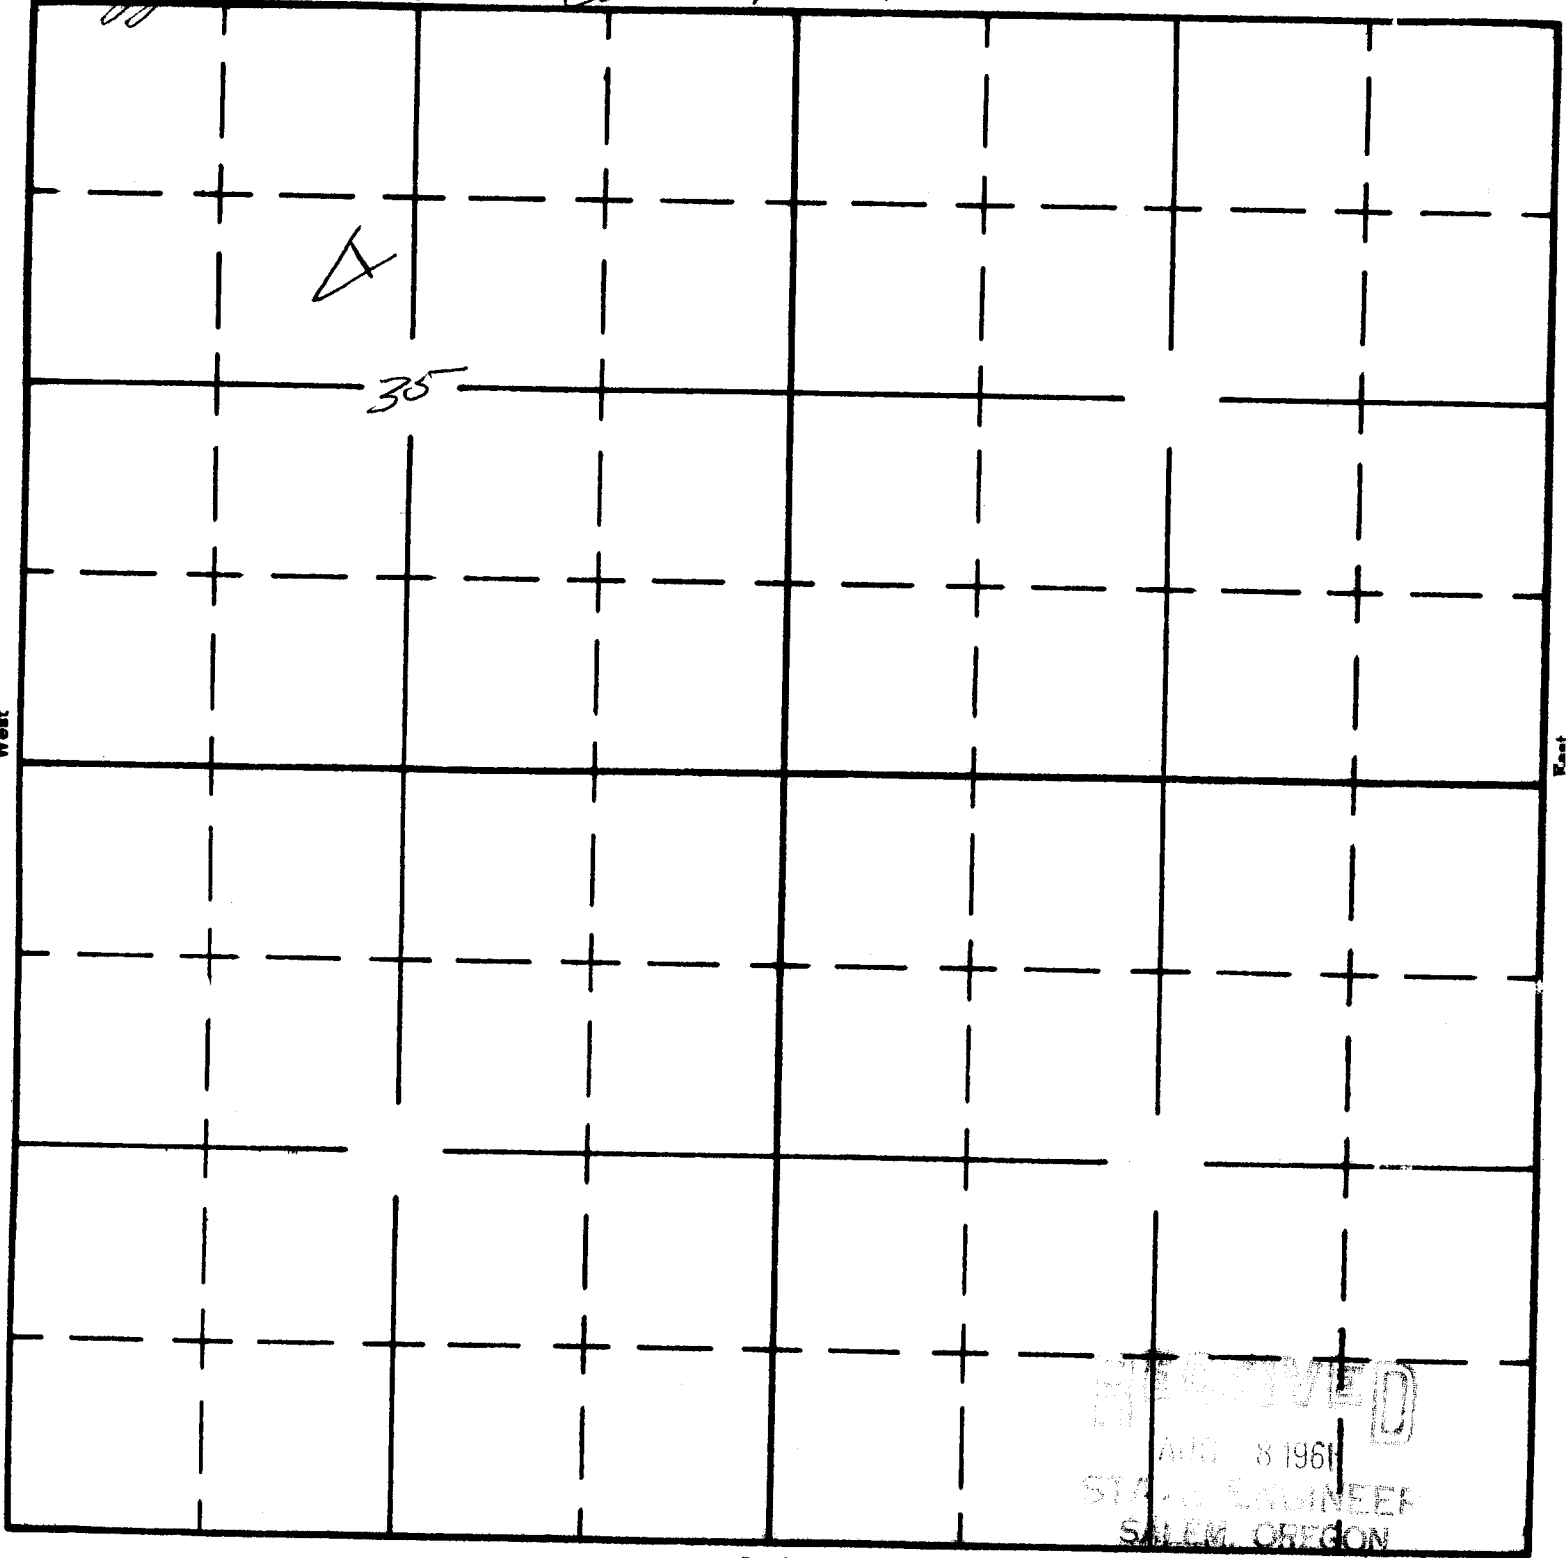

South

APPLICATION No. R-36851
PERMIT No. R-3400