

Form A1-187  
March 1961

UNITED STATES  
DEPARTMENT OF THE INTERIOR  
BUREAU OF LAND MANAGEMENT

SECTION 19



SW 1/4 NE 1/4

TOWNSHIP 19 S., RANGE 45 E., W. M.

JOHNSTON GULCH RESERVOIR

North

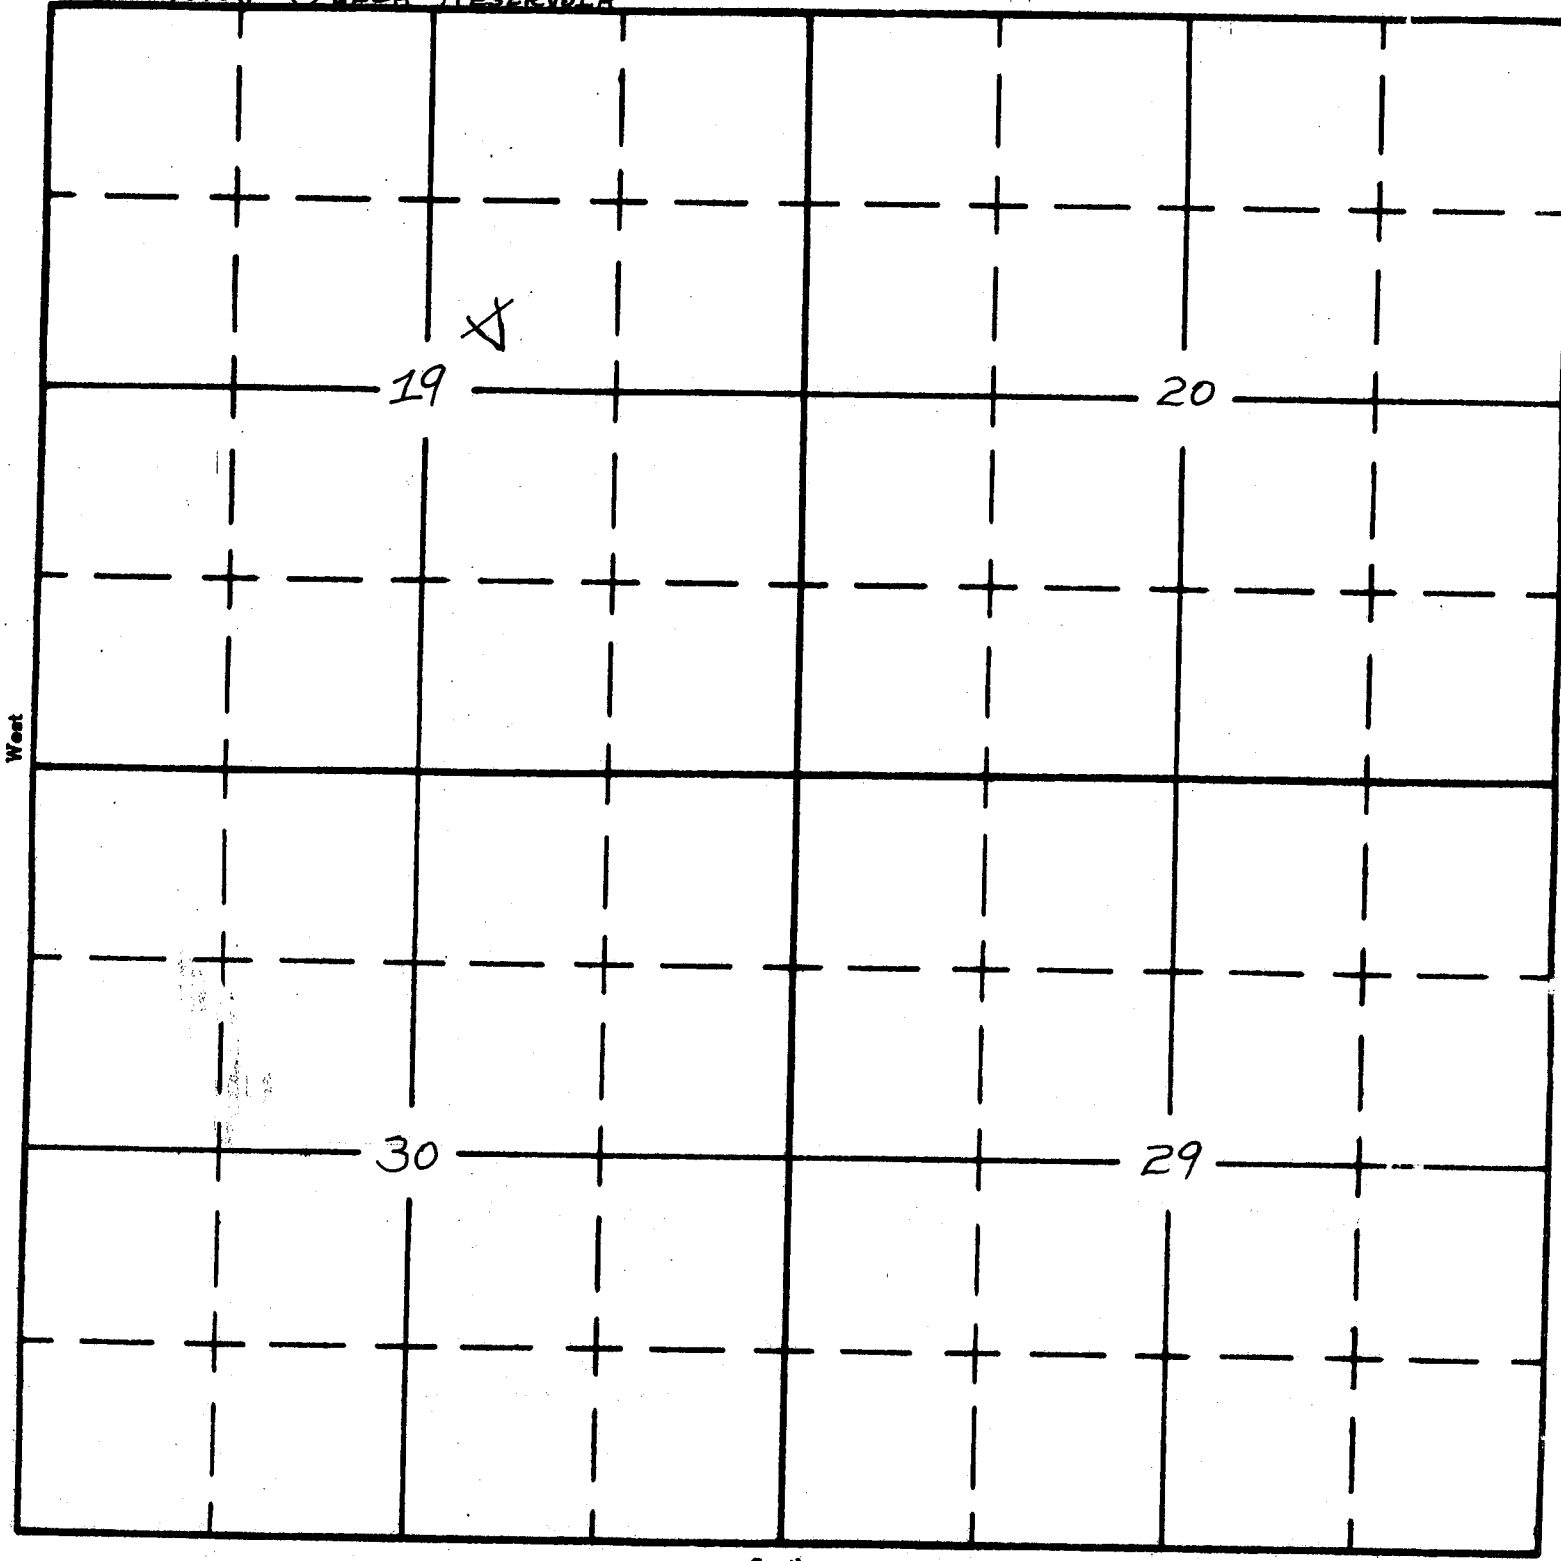

South

APPLICATION No. R-36876  
PERMIT No. R-3465