

187
1961

UNITED STATES
DEPARTMENT OF THE INTERIOR
BUREAU OF LAND MANAGEMENT

SECTION

30, 31


Oregon State Water Filings

TOWNSHIP 21S, RANGE 46E, W. M.

Four Points Reservoir

North

STATE ENGINEER
JUL 6 1961

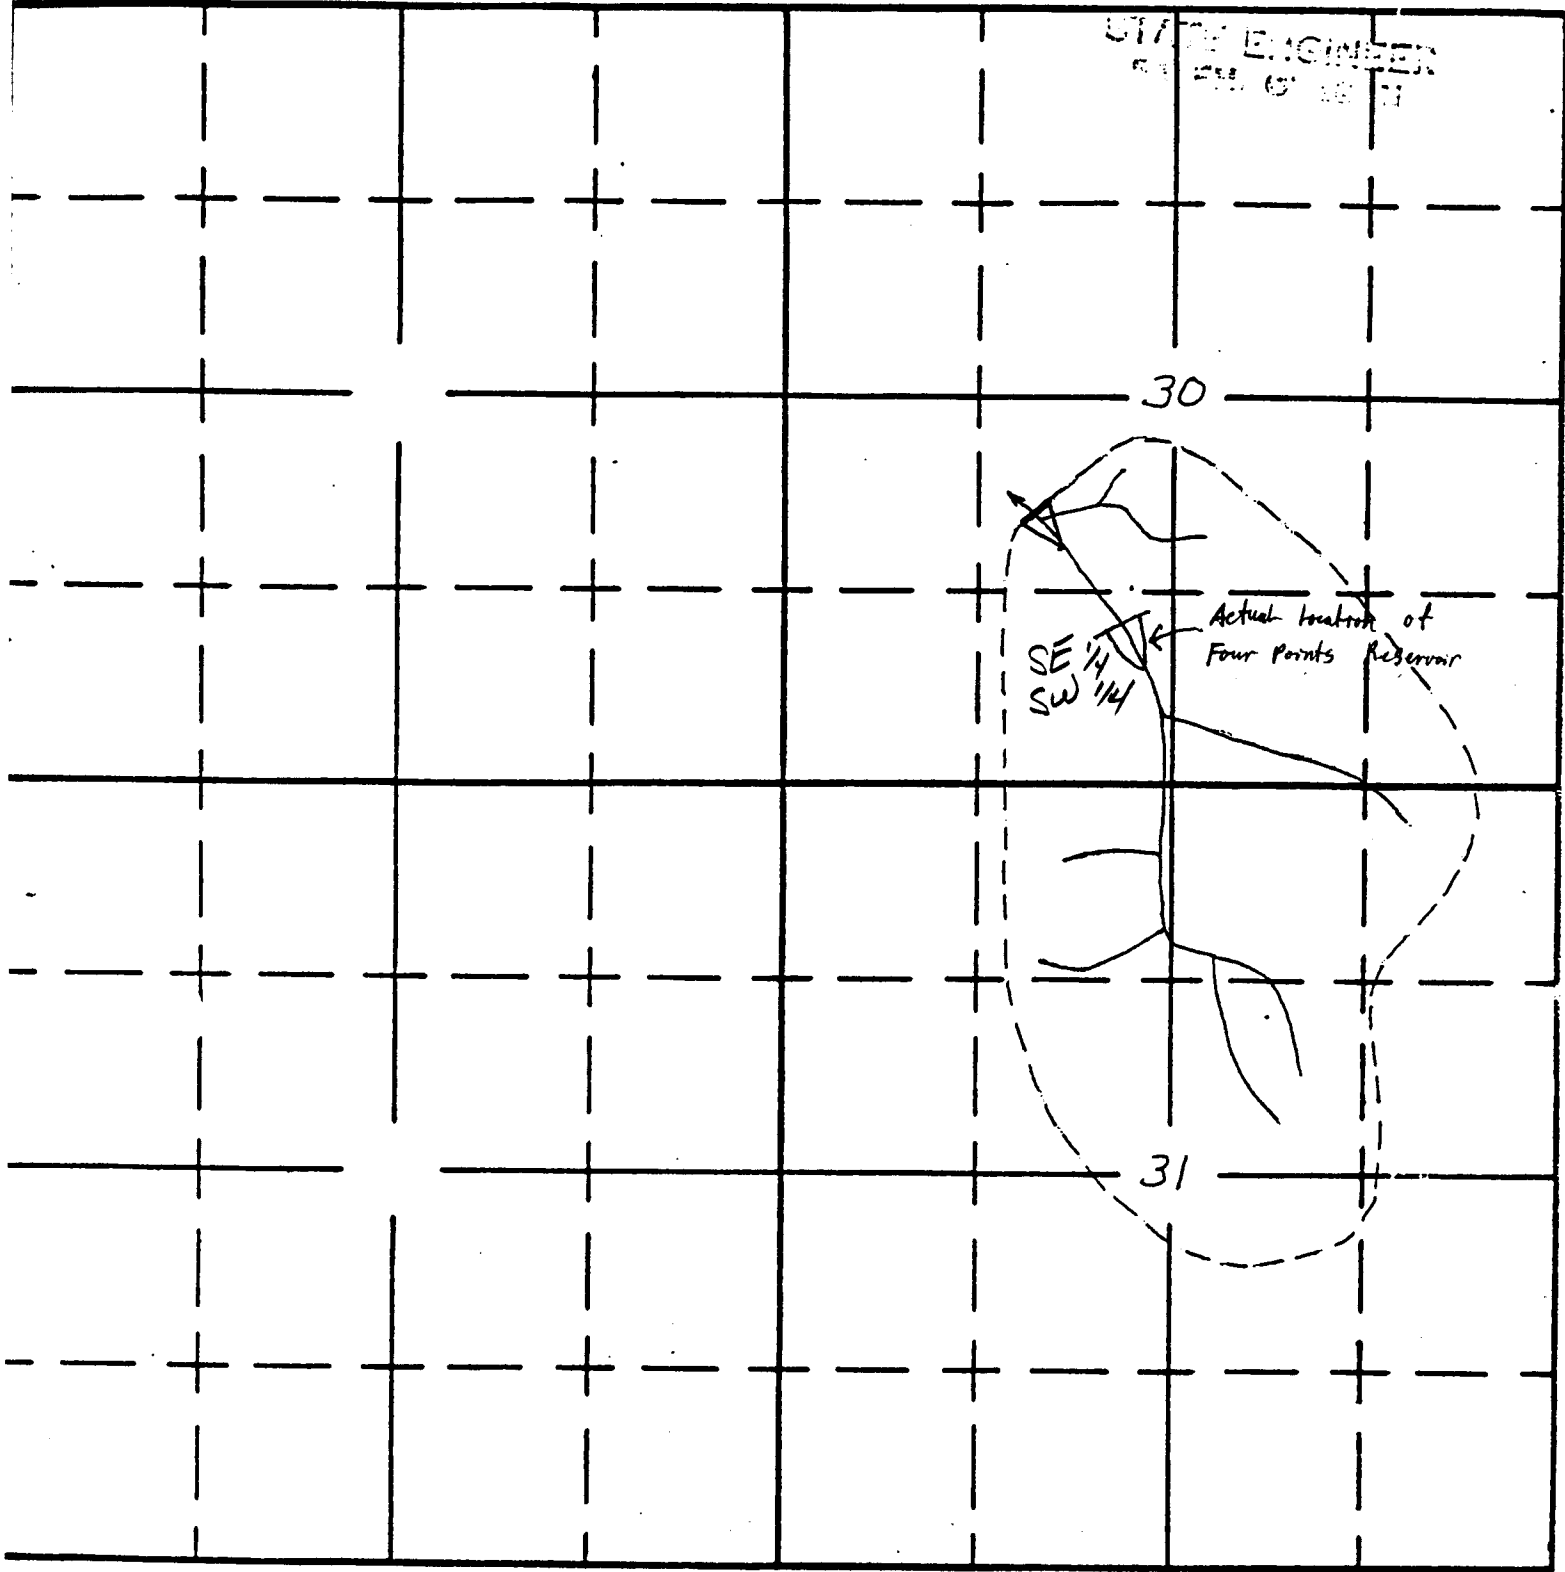

South

APPLICATION No. R-3954

DEDATE No. 0-114.