


RECEIVED

AUG - 1979

WATER RESOURCES DEPT
SALEM, OREGON

T. 24 S. R. 40 E. W.M.

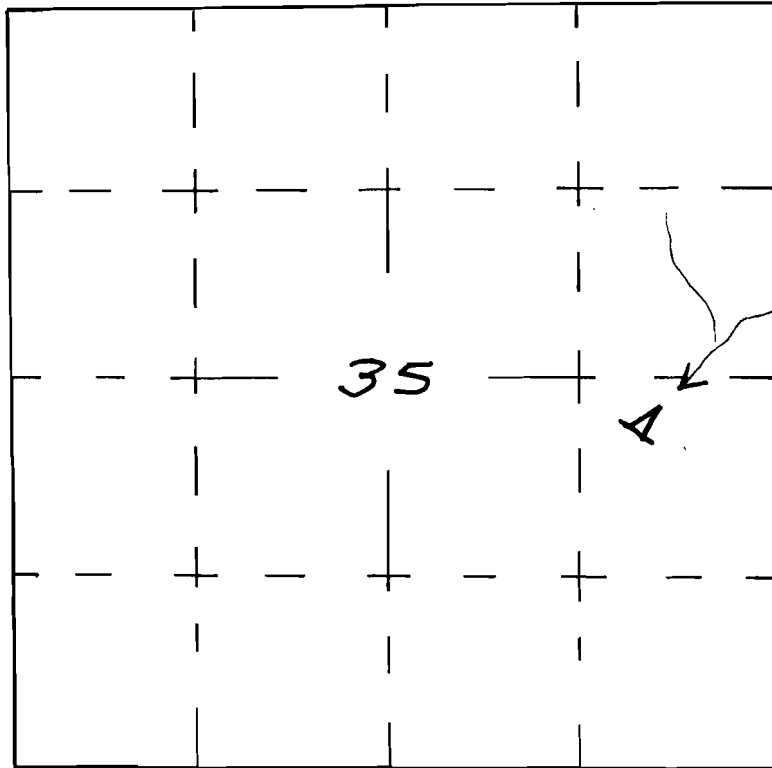

Application No. R59057
Permit No. R 8703

U. S. DEPARTMENT OF THE INTERIOR
BUREAU OF LAND MANAGEMENT

SLEEPY

DESIGNED _____

RECOMM. _____

DRAWN _____

RECOMM. _____

CHIEF, DIV. OF ENG.

CHECKED _____

APPROVED _____

SCALE _____

DATE _____

SHEET _____ OF _____

DRAWING NO. _____

APPLICATION MAP


RESERVOIR LOCATION CHANGE

NW 1/4 SE 1/4 SEC 35 T 24S R 40E W.M.

U.S.G.S. - SKULL SPRINGS, OREG. - 7 1/2'

LEGEND

-  RESERVOIR
-  ROAD
-  CHANNEL
-  FD SEC COR
-  SPRING

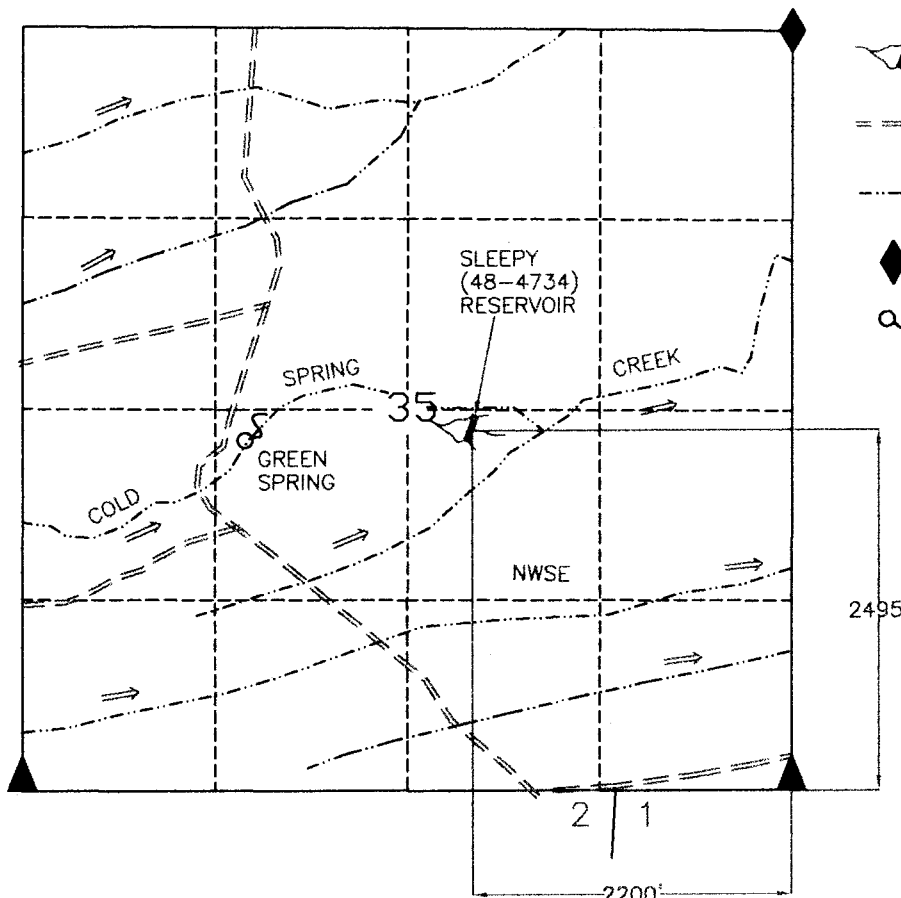


SLEEPY (48-4734) RESERVOIR

RECEIVED

MAR 07 2002

WATER RESOURCES DEPT.
SALEM, OREGON

LAT. 43°26'13.76803"
LONG. 117°46'46.51771"

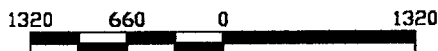

SCALE 1"=1320'

THIS MAP IS FOR THE PURPOSE OF LOCATING
A WATER RIGHT AND IS NOT INTENDED TO
PROVIDE LEGAL DIMENSIONS FOR LOCATION
OF PROPERTY BOUNDARIES.



ACAD2000
DWG FILE: SLEEPY4734

UNITED STATES DEPARTMENT OF THE INTERIOR
BUREAU OF LAND MANAGEMENT
DIVISION OF OPERATIONS VALE DISTRICT

SLEEPY (48-4734)
RESERVOIR

DESIGNED

REVIEWED

APPROVED

CHIEF, BRANCH OF ENGINEERING

DRAWN: CG

SCALE: 1"=1320'

DATE: 02/11/02

SHEET 1 OF 1

DRAWING NO. OR-03-9172.45-1068