


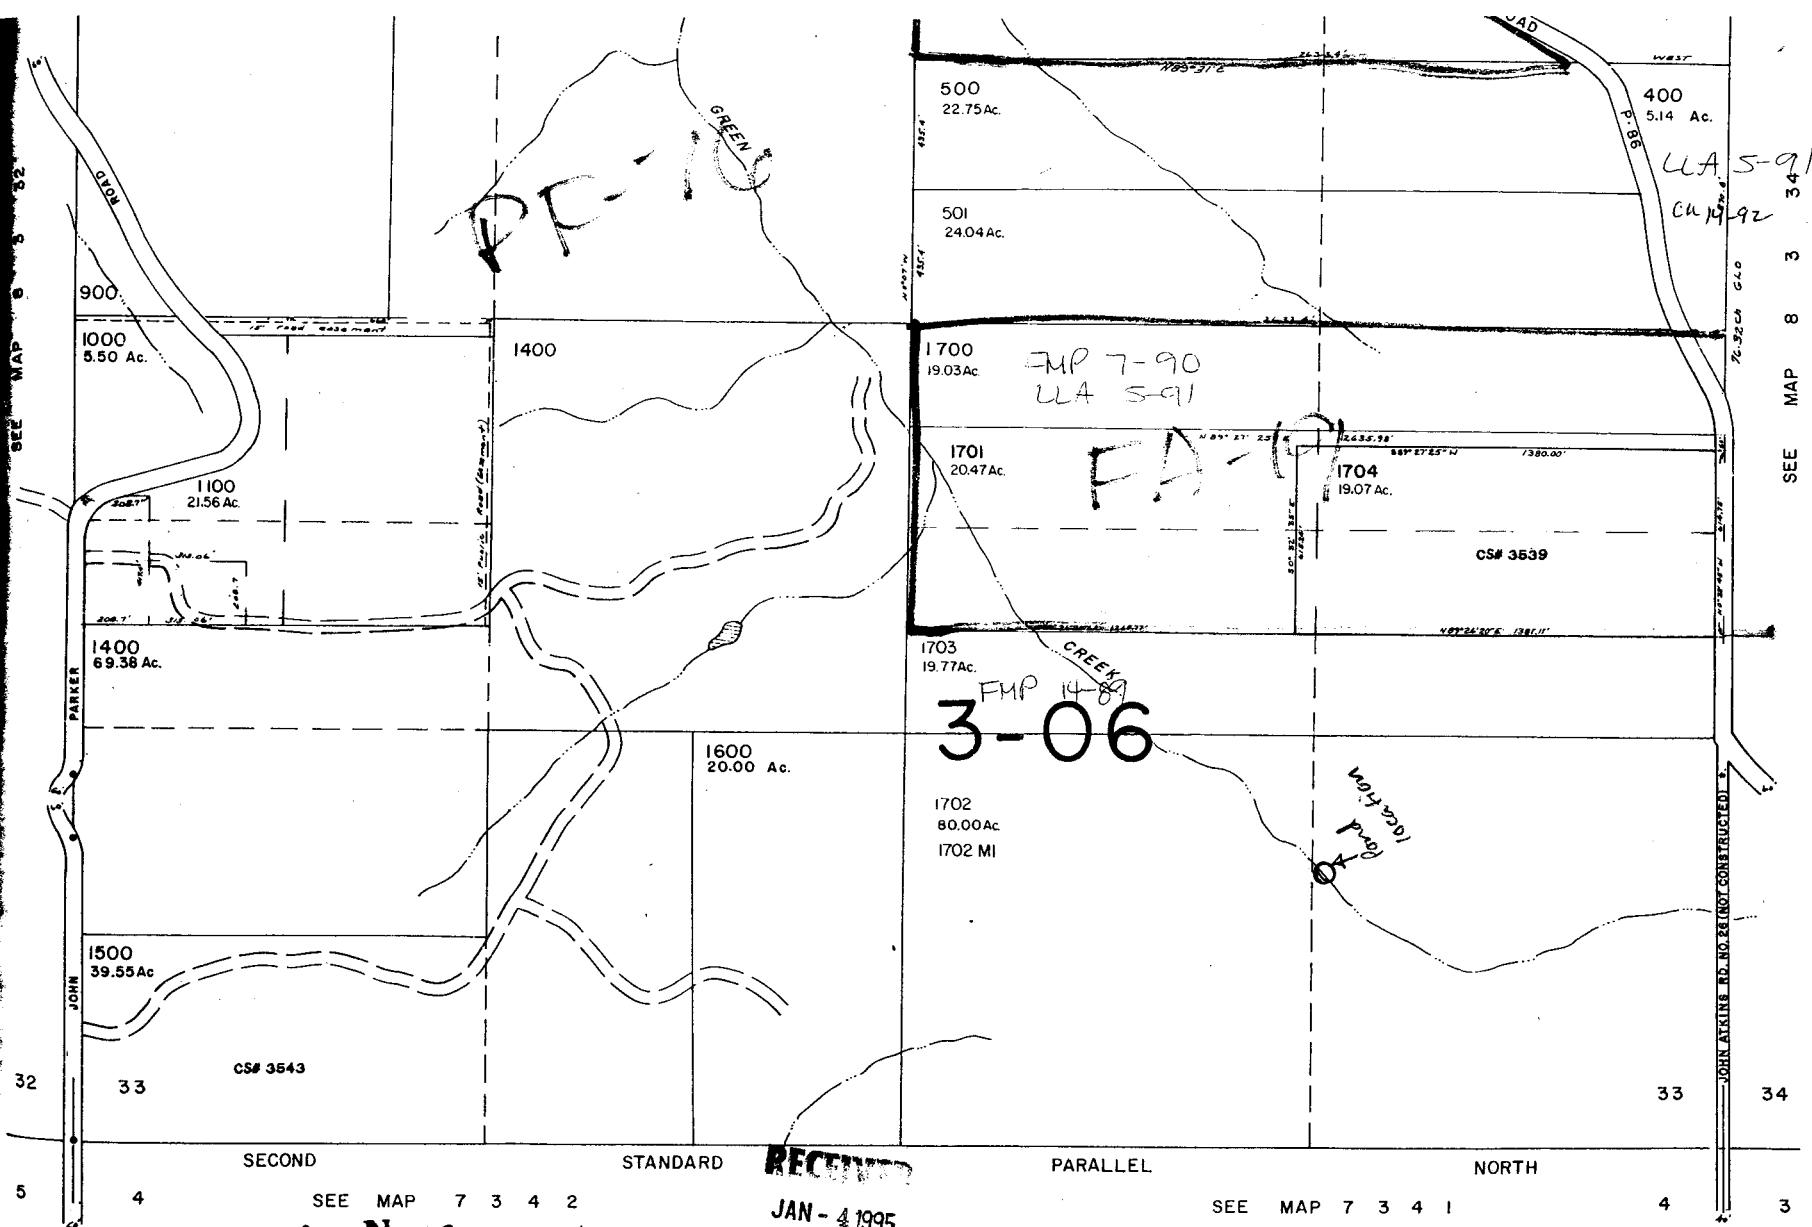

RECEIVED
JAN 03 1995
WATERMASTER
HILLSBORO, OR

Application No. R-77144
Permit No.

RECEIVED
JAN - 4 1995
WATER RESOURCES DIV.
SALEM, OREGON

CERTIFICATE NO. 70921

8 3 33