


T.2S., R.1E., W.M.

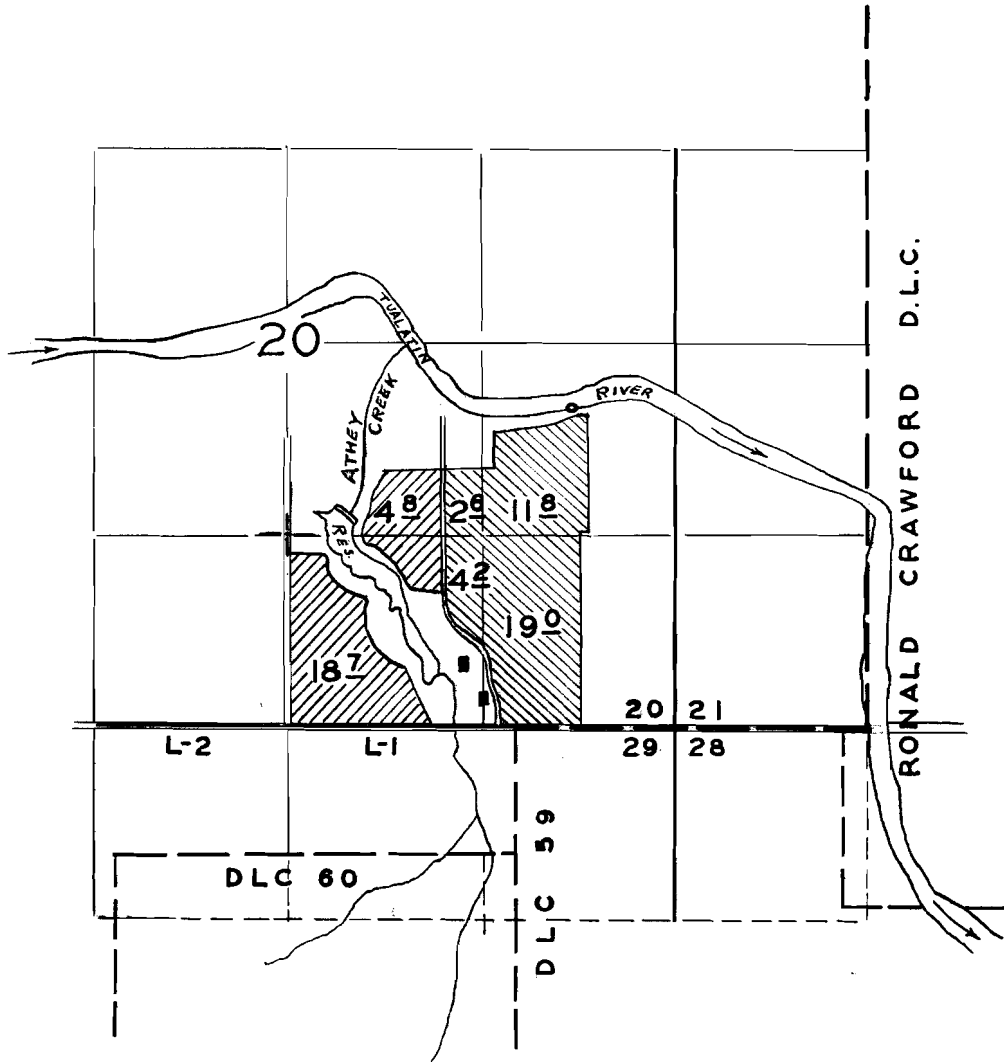

**FINAL PROOF SURVEY**

UNDER

R-28080

R-1421

Application No. 2700.5 Permit No. 21665

IN NAME OF

SCHABER BROTHERS

Surveyed 5-9 1956 by R.D. BEST.

////// FROM RESERVOIR

////// FROM TUALATIN RIVER