



T.7S., R.2W., W.M

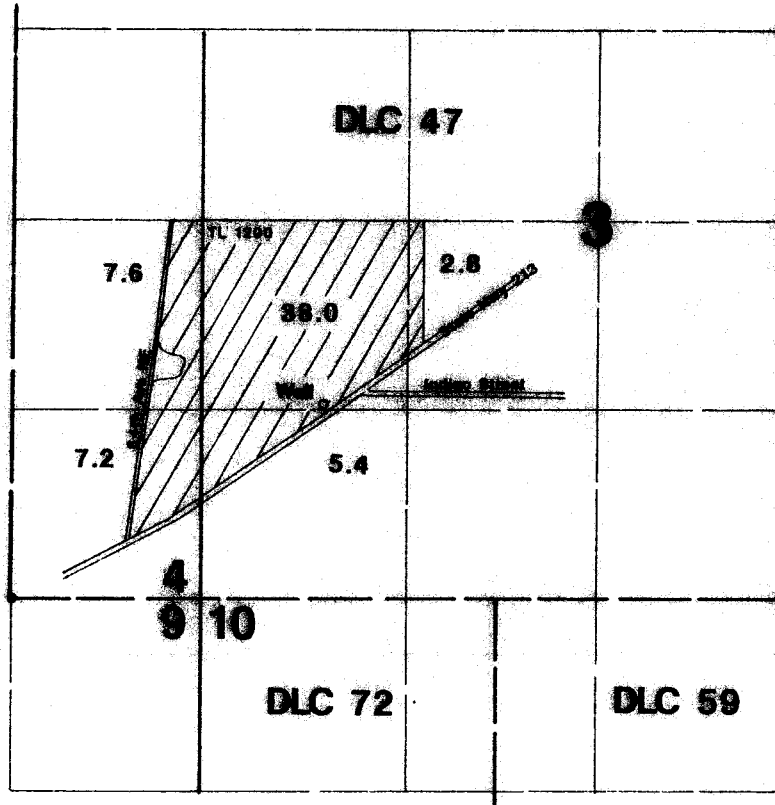

New POA (well) is located 1350'N & 2260'E from the SW corner of DLC 47.

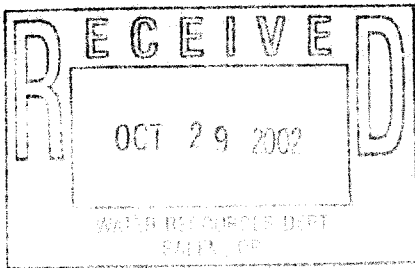

Final Proof Survey

In Name Of

Carl F. Jensen

Transfer #: T-8348

Surveyed on October 24, 2002 by JM Schuette

This Map Was Prepared For The Purpose Of Identifying The Location Of A Water Right Only And Is Not Intended To Provide Legal Dimensions Or Location Of Property Ownership Lines.

