


T.2 S., R.2 E., W.M.

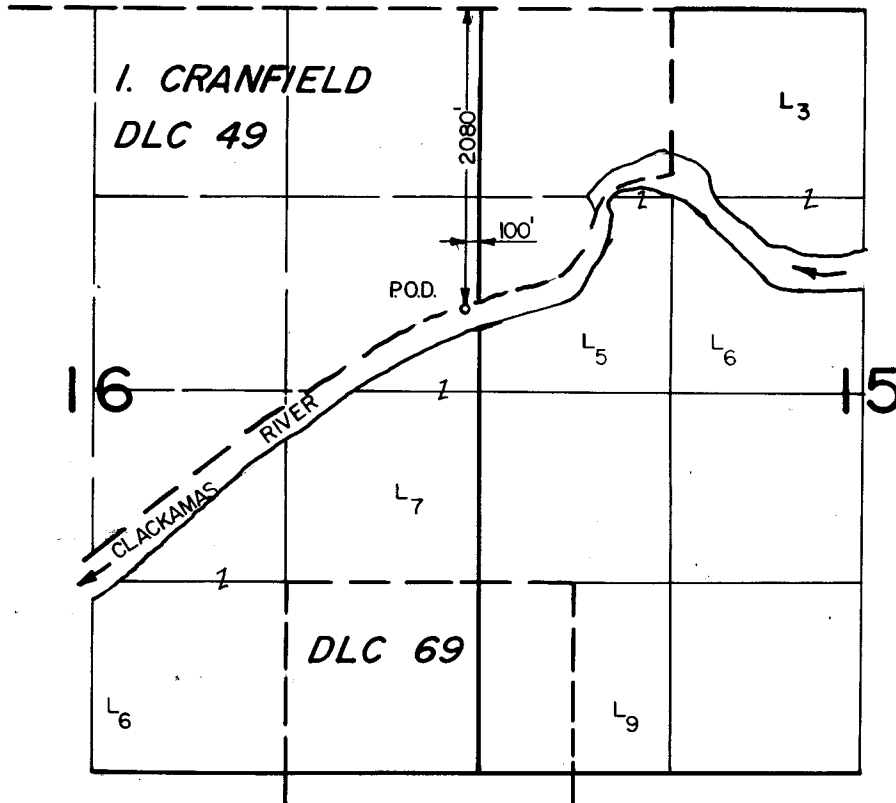

Scale : 1" = 1320'

**FINAL PROOF SURVEY**  
UNDER

TRANSFER 5791

Application No. .... Permit No. ....  
IN NAME OF

**CITY OF GLADSTONE**

Surveyed Oct. 10, 1986, by T. Warren

DFK-3LL-74  
2/23/87 TMW