



T. 4 N., R. 29 E., W.M.

1" = 1320'

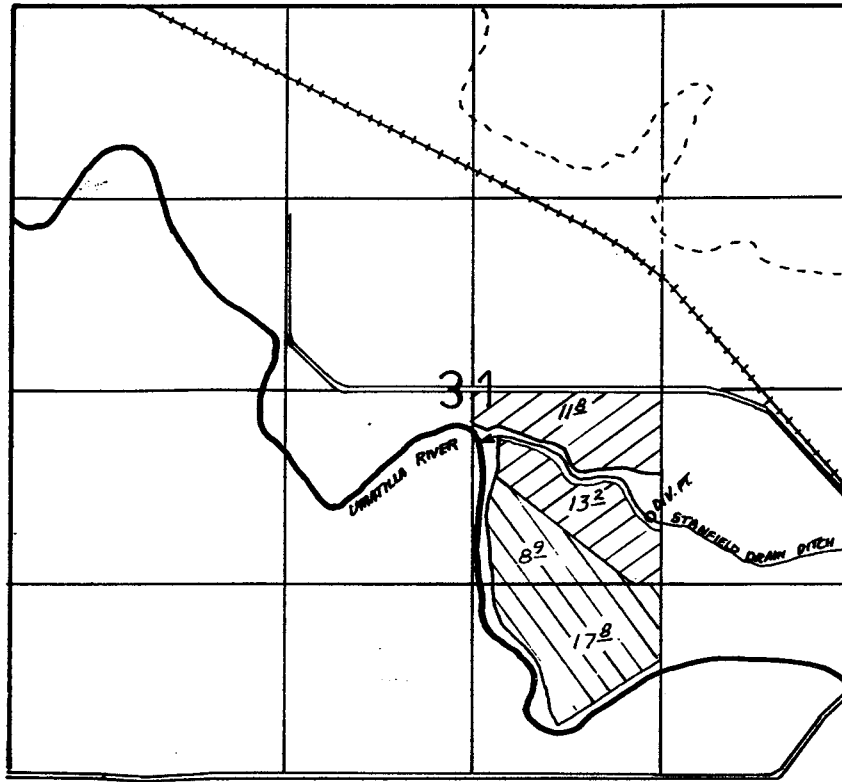

DIV. POINT - 850' S. AND 60' W. FROM THE N.E COR. OF NW. 1/4 OF S.E. 1/4, SEC. 31

-  PRIMARY
-  SUPP'L

FINAL PROOF SURVEY UNDER

Application No. 59543 Permit No. 45370
IN NAME OF

A. E. STALEY MANUFACTURING COMPANY

Surveyed 8-25, 1992, by J. MILLER