


T. 39 S., R. 3 W., W. M.

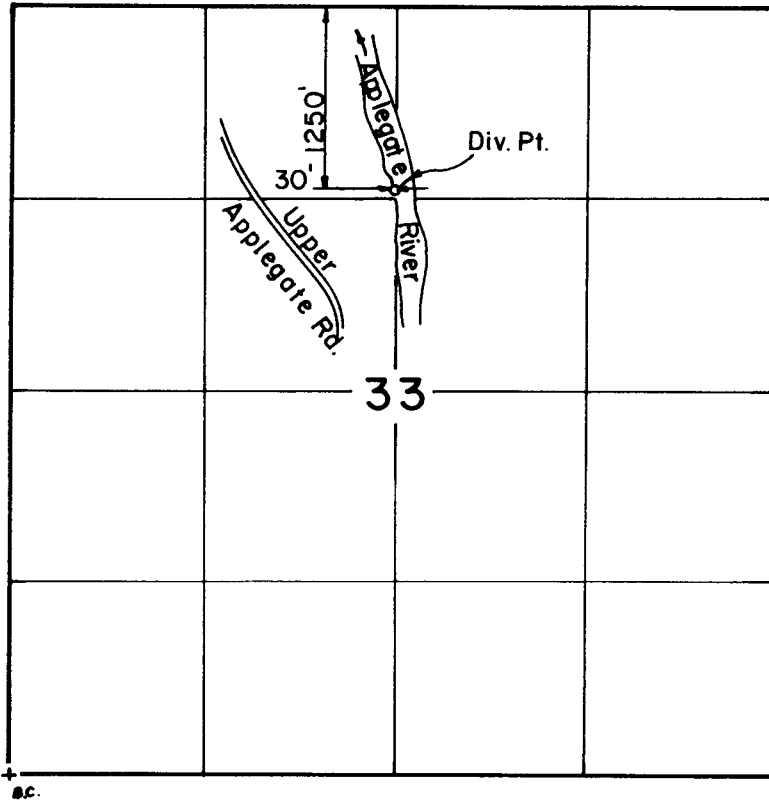

Scale: 1" = 1320'

**FINAL PROOF SURVEY  
UNDER**

TRANSFER NO. 5722

Application No. .... Permit No. ....

IN NAME OF

DENNIS... & ... KATHLEEN COOPER

Surveyed OCT. 24. 1991., by L.M. JOACHIMS