




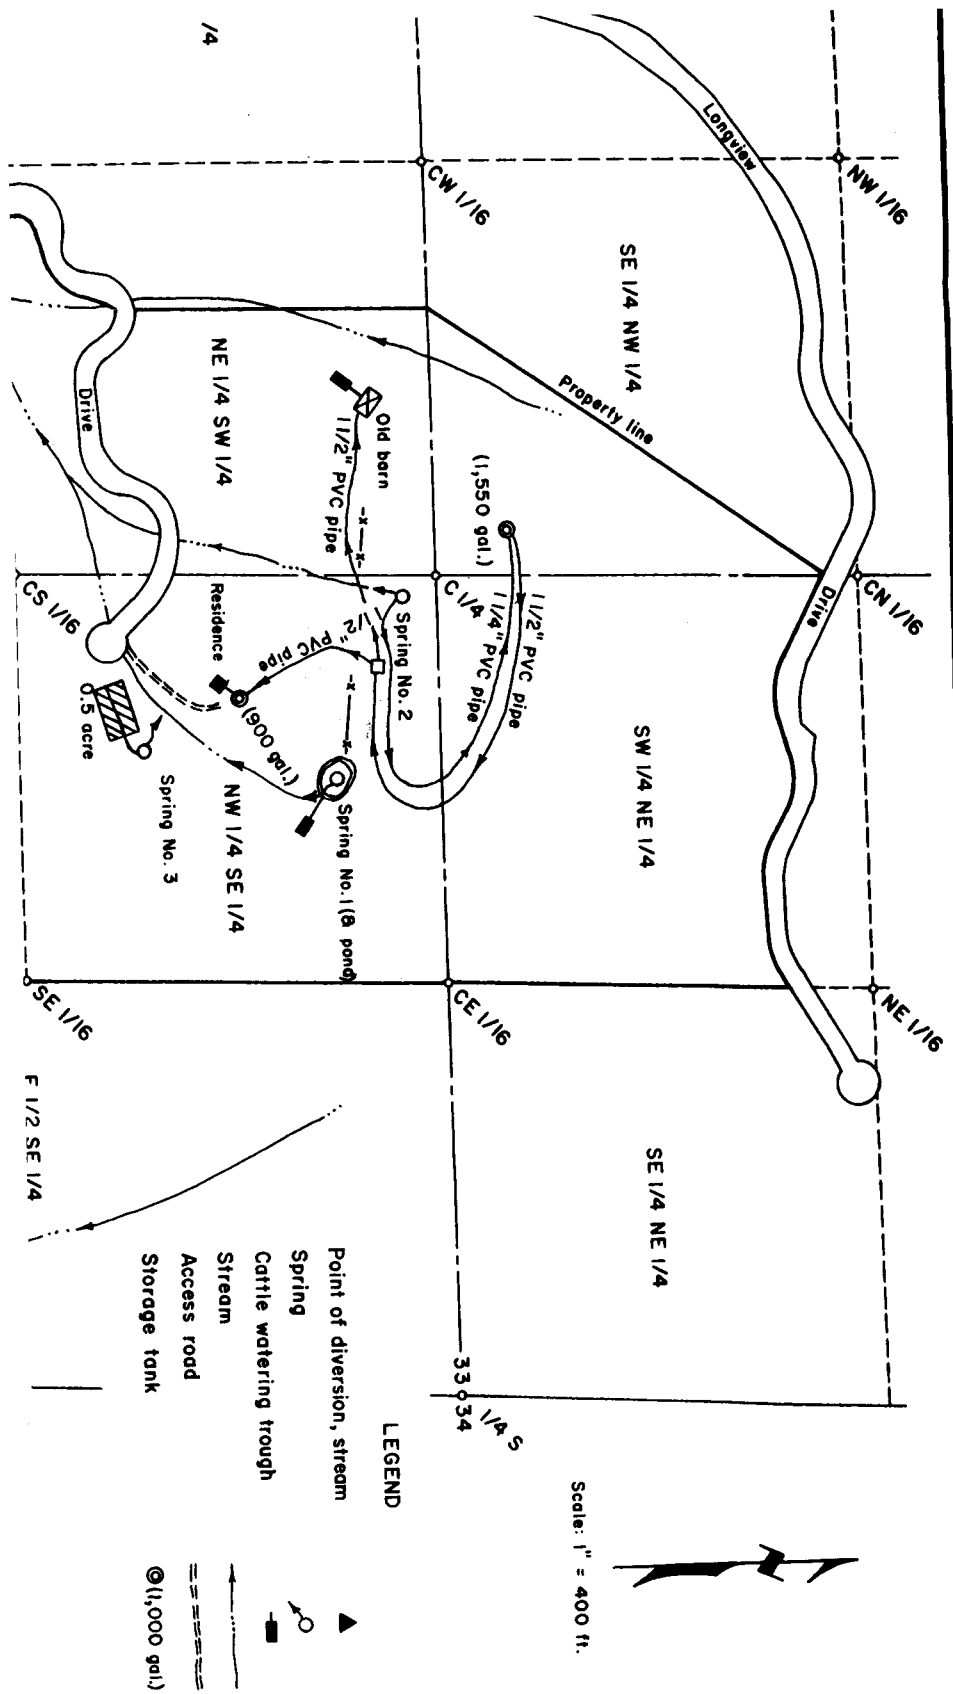

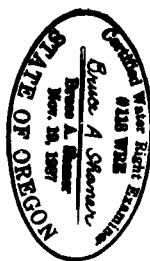

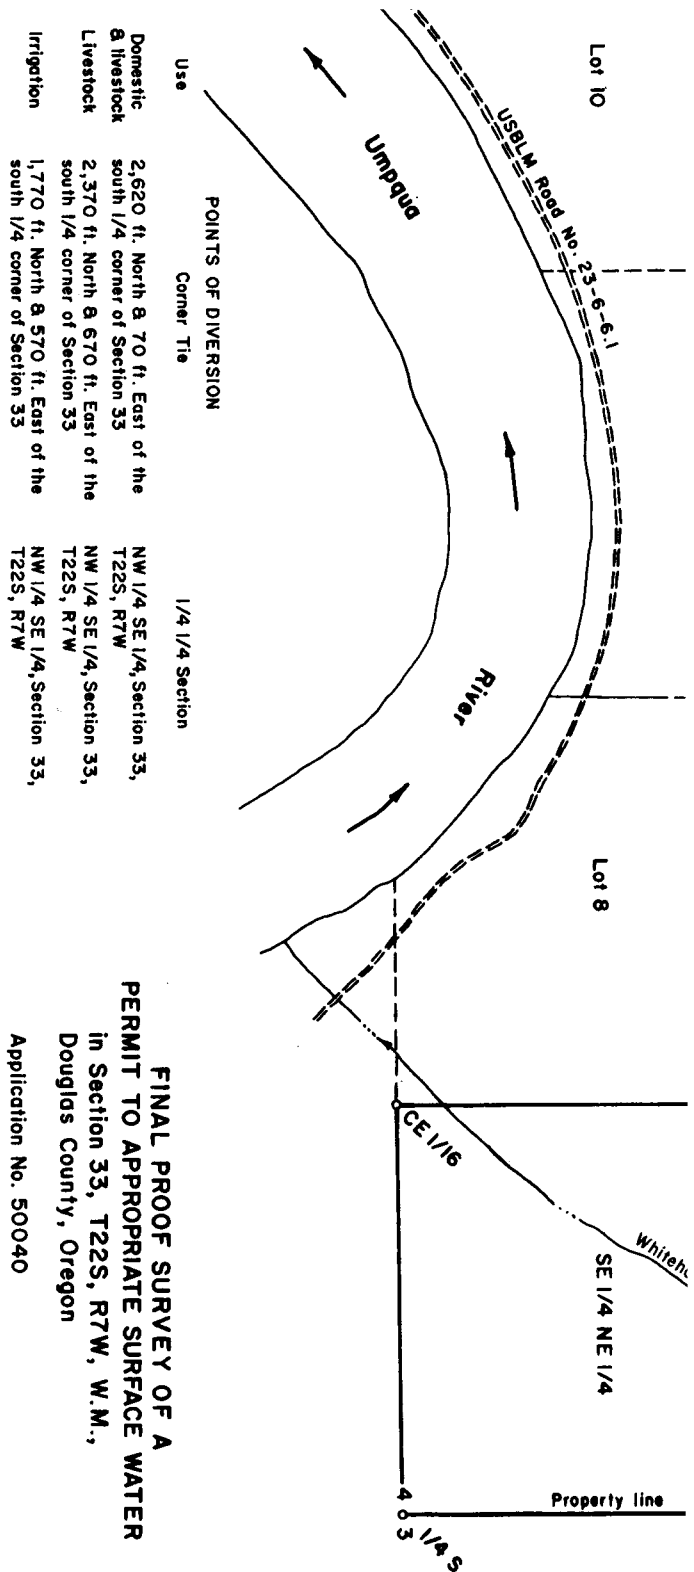

**FINAL PROOF SURVEY OF A
PERMIT TO APPROPRIATE SURFACE WATER
in Section 33, T22S, R7W, W.M.,
Douglas County, Oregon**

Application No. 50040

Permit No. 39108

For: Allan B. Branscomb
597 W. 29th Place
Eugene, Oregon 97405

By: Shoner Engineering, Inc.
P. O. Box 1430
Roseburg, Oregon 97470

September 27, 2000