


**CLAIM OF BENEFICIAL USE
FINAL PROOF MAP**
 Located in the NW1/4 SE1/4 of Section 33,
 Township 21 South, Range 4 West, W.M.
 Douglas County, Oregon
 Application S-84312 Permit 53743

Prepared For: Judith C. & Burre E. Elmore
 Prepared By: Dennis Goude
 Surveyed: October 10, 2001

Scale 1" = 400 Feet

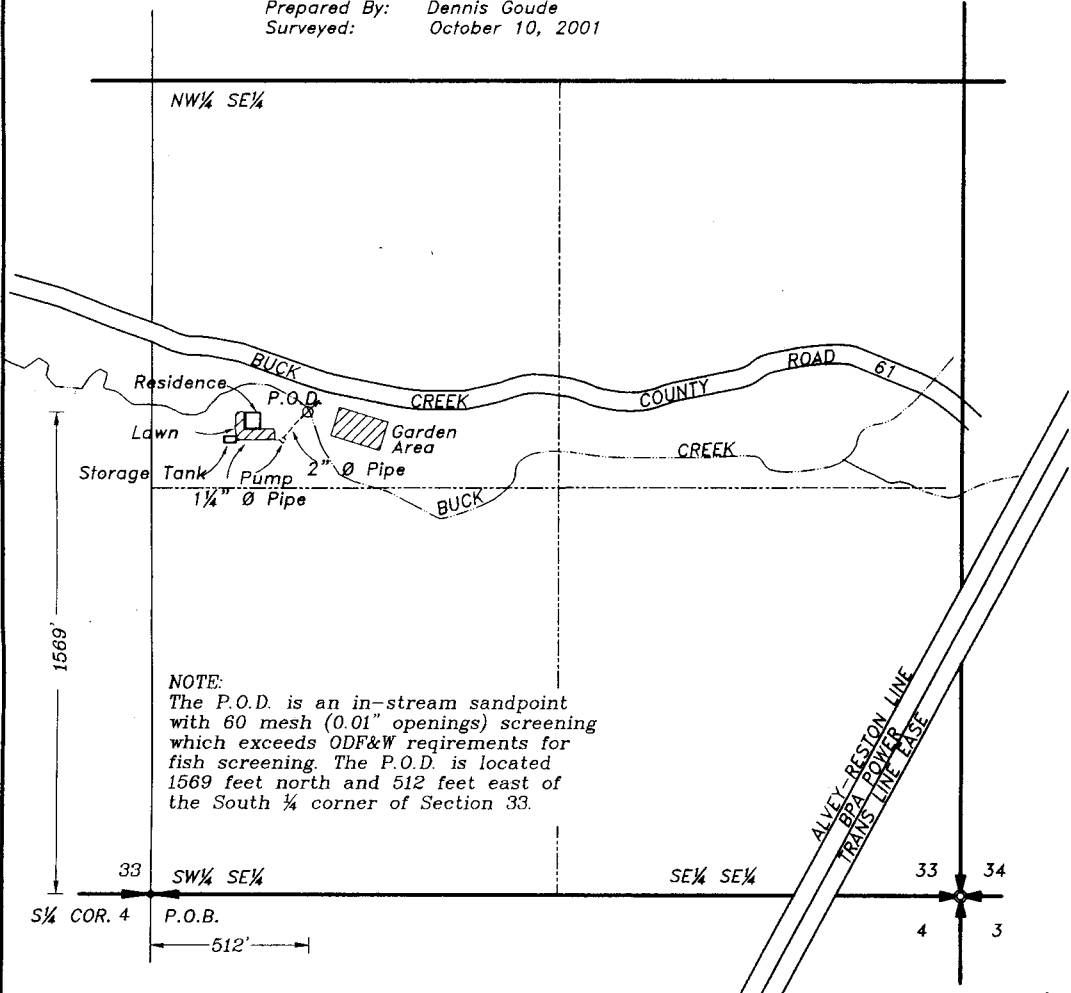

Certified Water Right Examiner
 441WRE
Thomas M. Hoshall
 Thomas M. Hoshall
 June 13, 1997
 STATE OF OREGON
 EXPIRES 06/30/2003

LEGEND
 P.O.B.
 P.O.D.
 PIPE
 STORAGE TANK

Stuntzner Engineering & Forestry, L.L.C.
 ENGINEERING • LAND SURVEYING • FORESTRY
 PLANNING • WATER RIGHTS
 706 South 4th St. Phone: (541) 267-2872
 Post Office Box 118 Coos Bay, Oregon 97420 Fax: (541) 267-0568

Drawn By: Dennis Goude	Date: November 15, 2001
Checked By: Tom Hoshall	Drawing No.: 99-336
Designed By:	Revised:
Job Name: Elmore Final Proof	Sheet 1 of 1

RECEIVED
 JAN 02 2002
 WATER RESOURCES DEPT.
 SALEM, OREGON

WATER EXAMINER'S STATEMENT
 The preparation of this map was for the purpose of identifying the location of the Water Right only and has no intent to provide dimensions or location of property ownership lines.