
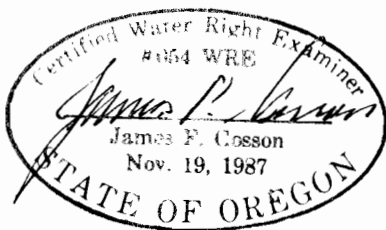


FINAL PROOF SURVEY MAP  
IN THE NAME OF **BARBARA L. FONTAINE**  
OR  
**DONALD B. MORRISON**

SECTIONS 14 & 23, TOWNSHIP 27, SOUTH, RANGE 4 WEST, W.M.

APPLICATION S-72481

PERMIT 52787

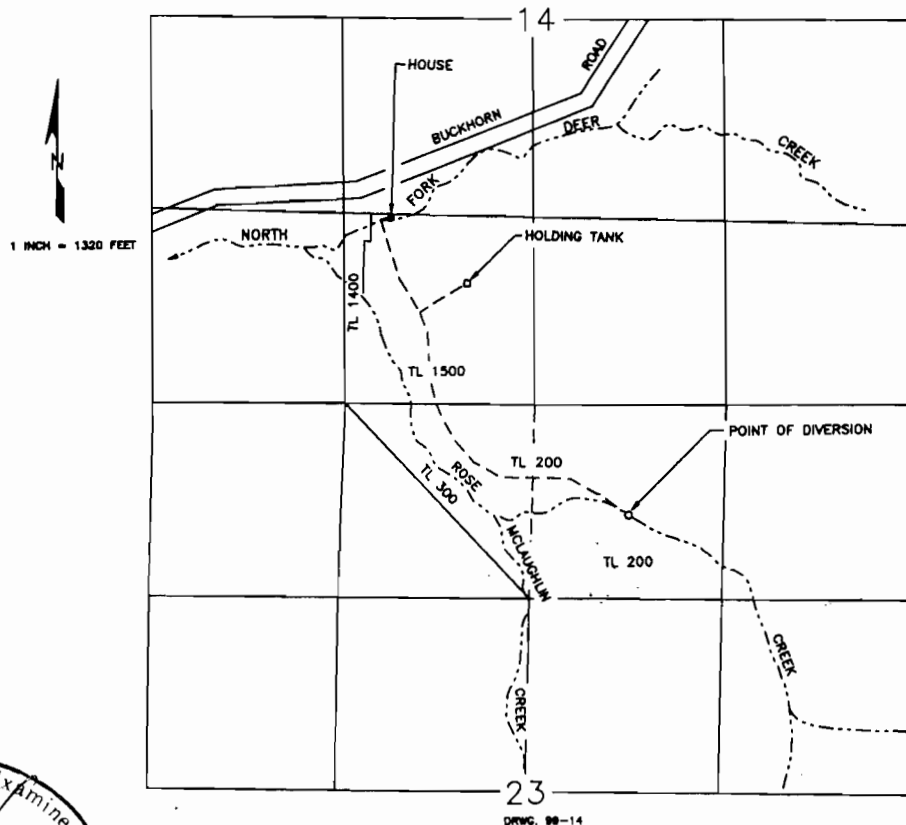

THE POINT OF DIVERSION IS LOCATED 760 FEET SOUTH AND 670 FEET EAST FROM THE NORTH 1/4 CORNER OF SECTION 23, BEING WITHIN THE NW 1/4 NE 1/4 SECTION 23, TOWNSHIP 27 SOUTH, RANGE 4 WEST, W.M., DOUGLAS COUNTY.

THE PURPOSE OF THIS MAP IS TO IDENTIFY THE LOCATION OF THE WATER RIGHT. IT IS NOT INTENDED TO PROVIDE INFORMATION RELATIVE TO THE LOCATION OF PROPERTY OWNERSHIP BOUNDARY LINES.