

RECEIVED

T. 29 S., R. 1 E., W.M.

SCALE: 1" = 400'

JUL 14 1999
WATER RESOURCES DEPT.
SALEM, OREGON

THE PURPOSE OF THIS MAP IS TO IDENTIFY THE LOCATION OF THE
WATER RIGHT. IT IS NOT INTENDED TO PROVIDE INFORMATION RELATIVE
TO THE LOCATION OF PROPERTY OWNERSHIP BOUNDARY LINES.

POINT OF DIVERSION IS 605 FEET
SOUTH AND 1057 FEET WEST OF
CORNER #1, H.E.S. #144, T. 29 S.,
R. 1 E., W.M.

COR. #1
H.E.S. #144
FD. B.C.

COR. #13
H.E.S. #144
FD. B.C.

POINT OF DIVERSION
SPRING

RESIDENCE WITH
LAWN AND
GARDEN

S.E. of the S.E.
TROUT POND
1.0 AC. SURFACE


TROUT POND
0.7 AC. SURFACE

2.65 AC.

FIELD
HAY AND PASTURE

FOREST

ROAD

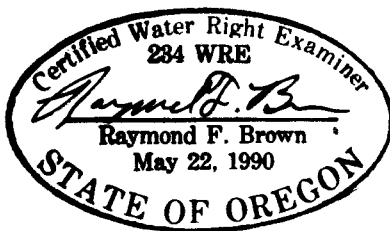

EXP. 12/31/99

FINAL PROOF SURVEY

UNDER

Application No. S-73769 Permit No. 52154

IN NAME OF

JERRY L. ROGERS

Surveyed: MAY 22, 1999 by: R. F. BROWN