

Point of diversion is 150 ft. South & 1,390 ft. West of the North 1/4 corner of Section 16.



Scale: 1" = 200 ft.


**FINAL PROOF SURVEY OF A
PERMIT TO APPROPRIATE SURFACE WATER
IN THE SW 1/4 SW 1/4 OF SECTION 9
& IN THE NW 1/4 NW 1/4 OF SECTION 16,
T26S, R3W, W.M., DOUGLAS COUNTY,
OREGON**

**Application No. 70346
Permit No. 51041**

For: John R. Morton
21034 North Umpqua Highway
Glide, Oregon 97443

By: Shaner Engineering, Inc.
P.O. Box 1430
Roseburg, Oregon 97470

September 11, 1995

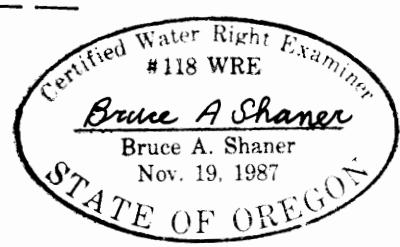

Renews June 30, 1996