


T. 7S. R. 3W. W.M.

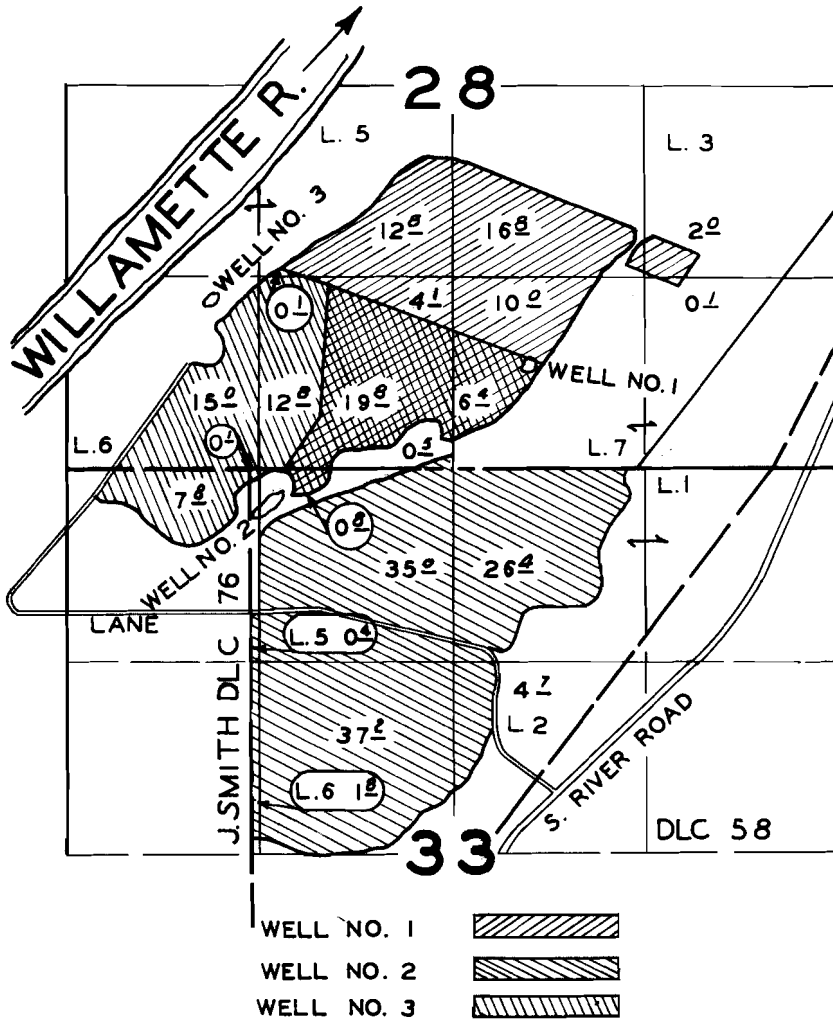

**FINAL PROOF SURVEY**  
UNDER

Application No. G1602 Permit No. G1474  
IN NAME OF

**THEODORE , ARNOLD & TURFIELD SCHINDLER**

Surveyed MAY 19 19 60, by *[Signature]*