


T.36S.R.2E.W.M.

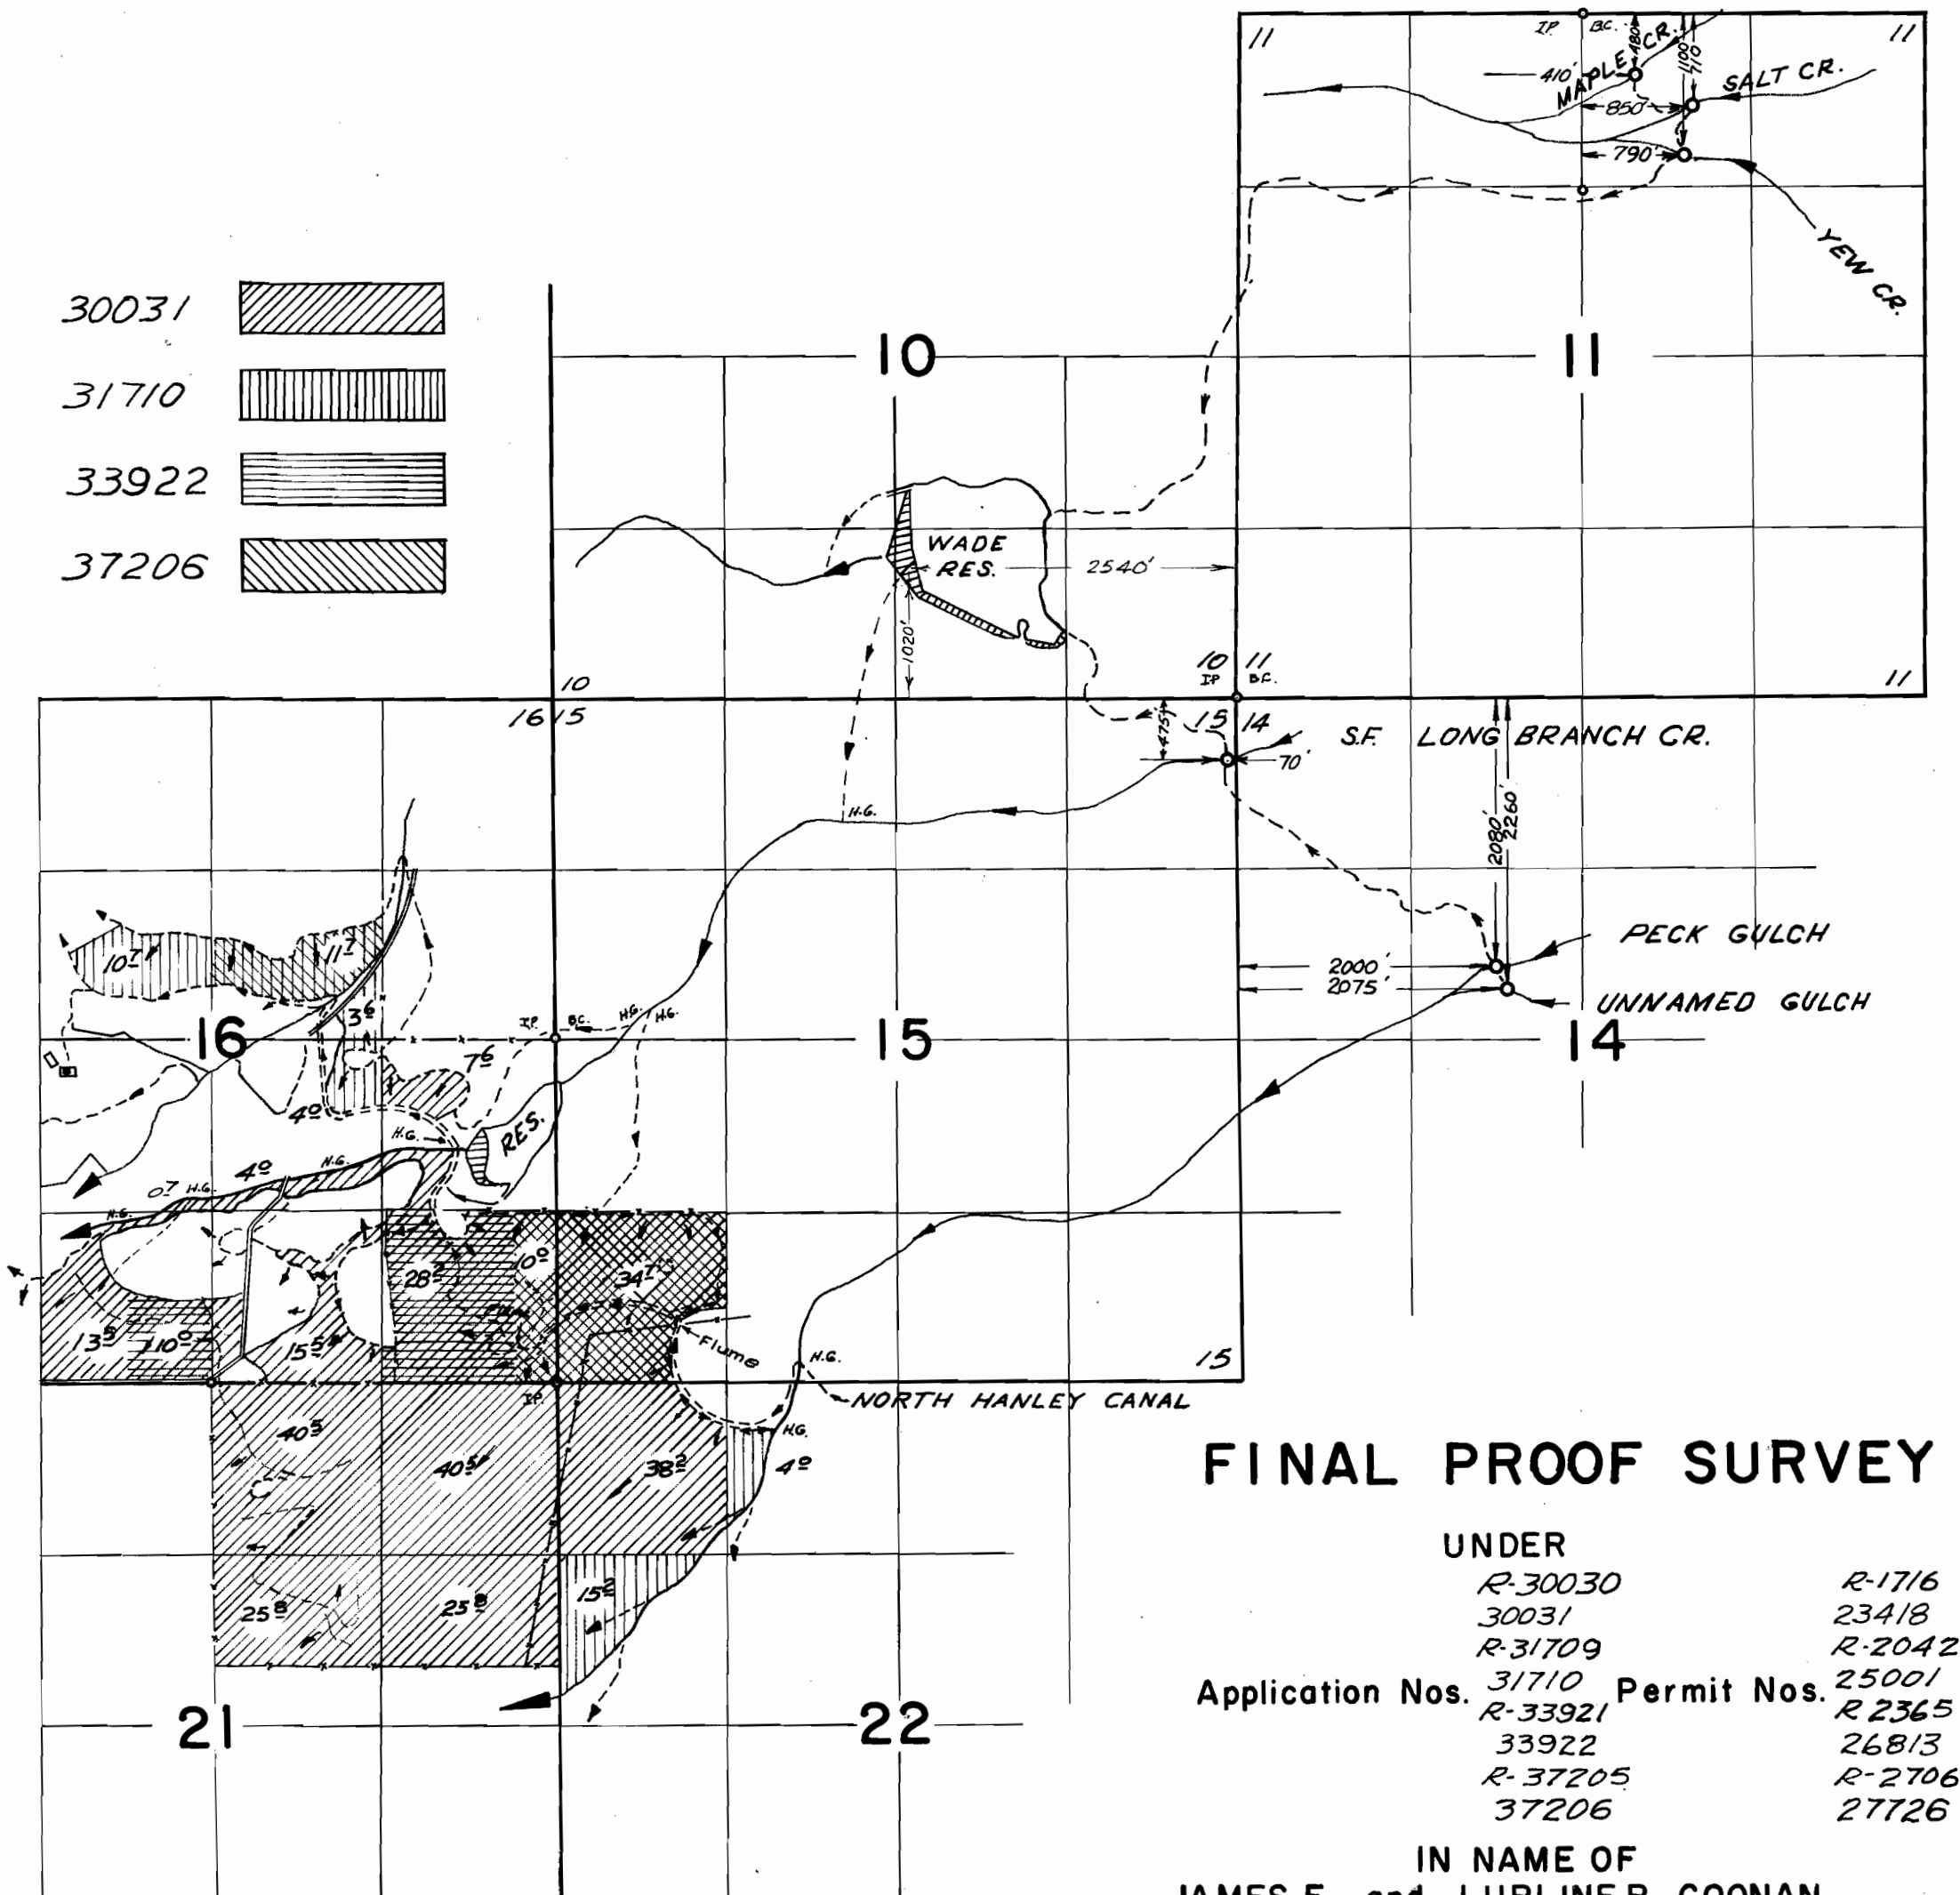

**FINAL PROOF SURVEY**

UNDER

R-30030	R-1716
30031	23418
R-31709	R-2042
Application Nos. 31710	Permit Nos. 25001
R-33921	R-2365
33922	26813
R-37205	R-2706
37206	27726

IN NAME OF  
JAMES F. and LURLINE R. COONAN

Surveyed June 8, 1966 By V. GARNER