


T. 23 S., R. 12 W.W.M.

SECTION 20

THIS MAP IS FOR THE PURPOSE OF LOCATING THE WATER RIGHT ONLY AND IS NOT INTENDED TO PROVIDE LEGAL DIMENSIONS OR LOCATIONS OF PROPERTY OWNERSHIP LINES.

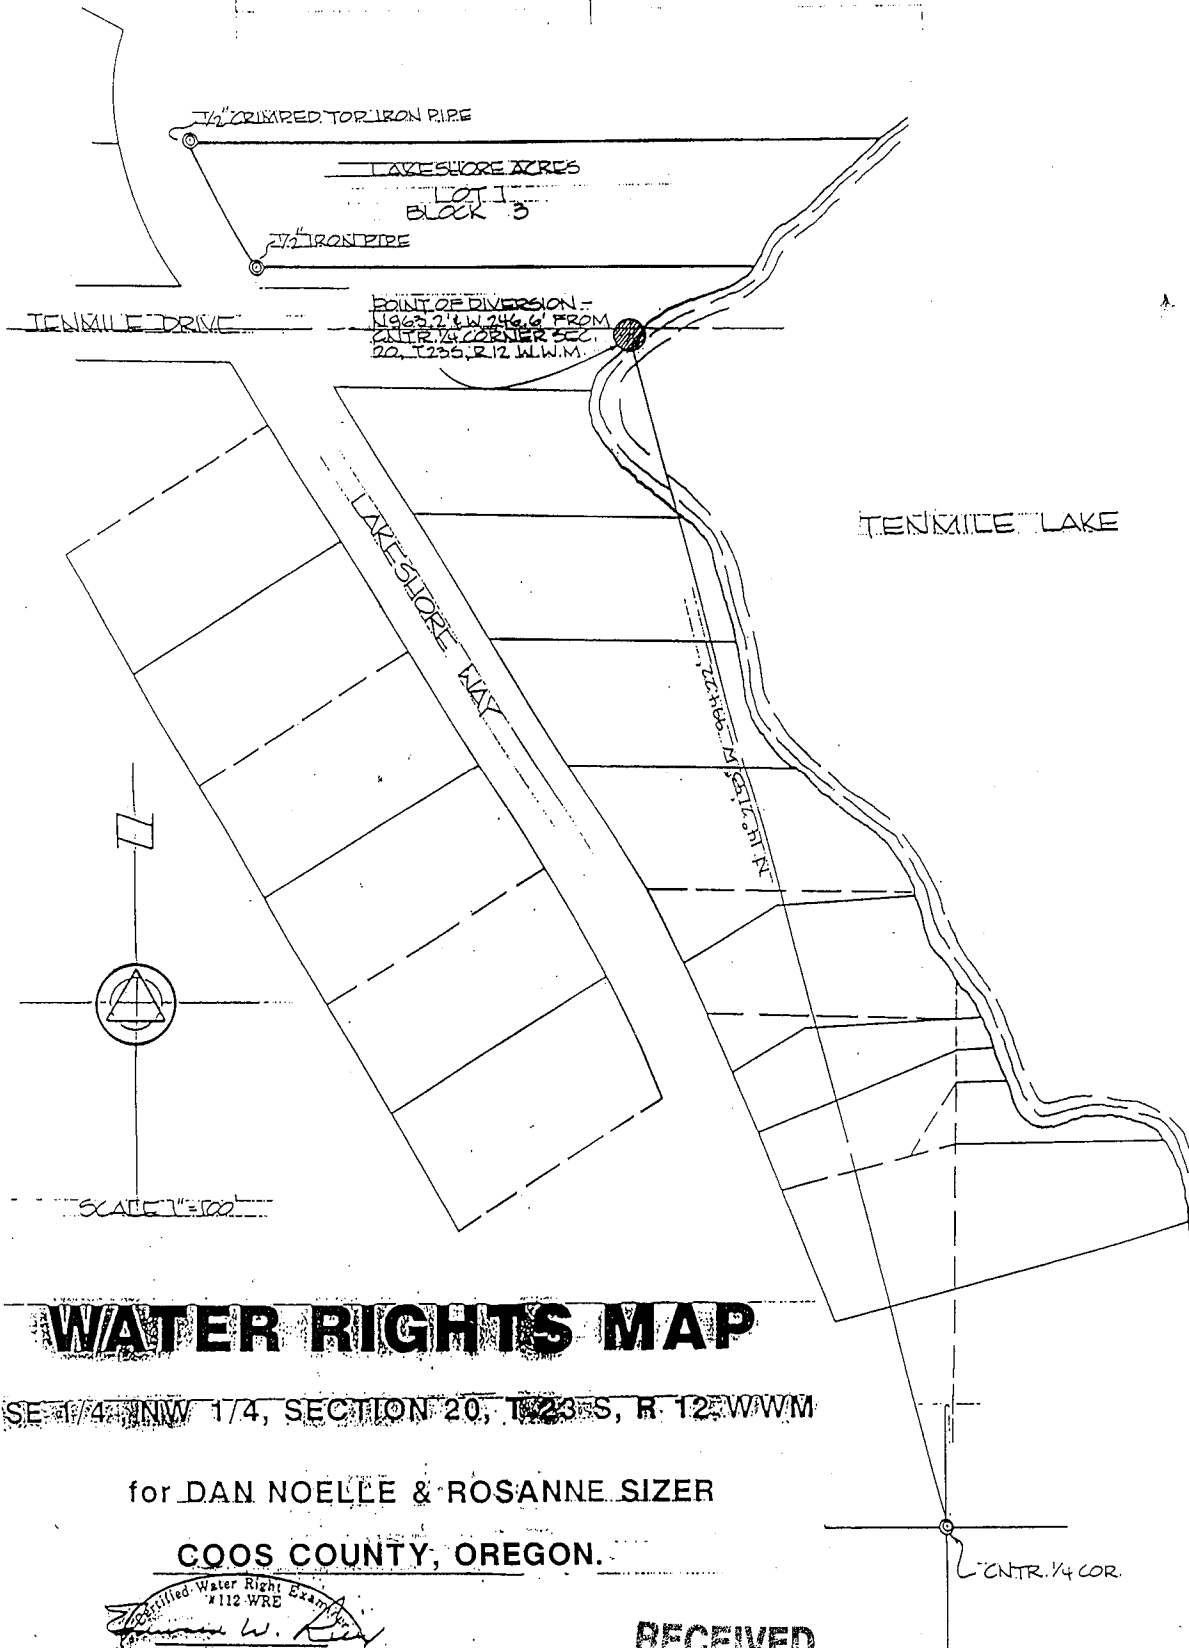


WATER RIGHTS MAP

SE 1/4, NW 1/4, SECTION 20, T. 23 S., R. 12 W.W.M.

for DAN NOELLE & ROSANNE SIZER

COOS COUNTY, OREGON.

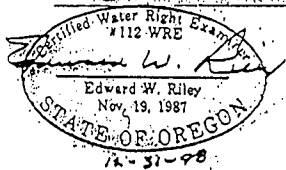

RECEIVED

MAR 26 1998

WATER RESOURCES DEPT.
SALEM, OREGON

MAR 18 1998
FEB 20, 1998


3356-DL-98

TRANSFER APPLICATION MAP
 LOCATED IN THE SE¼ NW¼ OF SECTION 20
 TOWNSHIP 23 SOUTH, RANGE 12 WEST, W.M.
 COOS COUNTY, OREGON
 APPLICATION S-80913 PERMIT 52461

PREPARED FOR D. J. NOELLE & ROSANNE SIZER
 PREPARED BY: DENNIS GOUDE
 DATE PREPARED: FEBRUARY 14, 2002




LAKESHORE ACRES

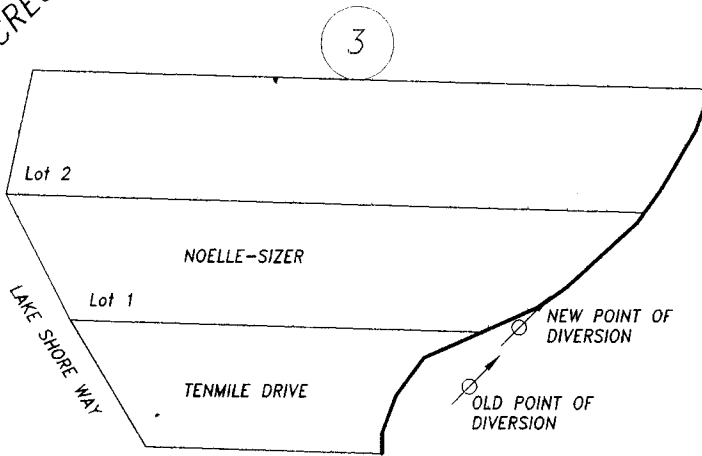

TENMILE LAKE

NOTE:
 THE OLD POINT OF DIVERSION WAS LOCATED
 963.2 FEET NORTH AND 246.6 FEET WEST
 FROM THE CENTER ¼ CORNER OF SECTION 20
 PER RILEY (WRE 112) FINAL PROOF SURVEY.
 THE NEW POINT OF DIVERSION IS LOCATED
 1016 FEET NORTH AND 209 FEET WEST FROM
 THE CENTER ¼ CORNER OF SECTION 20. THE
 P.O.D. IS A ½ HORSEPOWER GOULDS CENTRIFUGAL
 PUMP.

LEGEND

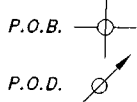

EXPIRES 06/30/03

POINT OF BEGINNING
 CENTER ¼ CORNER

**Stuntzner Engineering
 & Forestry, L.L.C.**

ENGINEERING • LAND SURVEYING • FORESTRY
 PLANNING • WATER RIGHTS

705 South 4th St. Phone: (541) 267-2872
 Post Office Box 118 Coos Bay, Oregon 97420 Fax: (541) 267-0588

Drawn By: Dennis Goude	Date: February 14, 2002
Checked By: Tom Hoshall	Drawing No.: 01-317
Designed By:	Revised:
Job Name: Noelle-Sizer Water Rights	Sheet 1 of 1

RECEIVED

MAR 07 2002

WATER RESOURCES DEPT.
 SALEM, OREGON

EXAMINERS DISCLAIMER STATEMENT

THE PREPARATION OF THIS MAP WAS FOR THE PURPOSE OF
 IDENTIFYING THE LOCATION OF THE WATER RIGHT ONLY AND
 HAS NO INTENT TO PROVIDE DIMENSIONS OR LOCATION OF
 PROPERTY OWNERSHIP LINES.