


Tax Lot No. TL900, TL1000, TL1100 & TL1200
Section 9 Township 23S Range 12W
Coos County

W.M.

RECEIVED

OCT 28 1997

WATER RESOURCES DEPT.
SALEM, OREGON

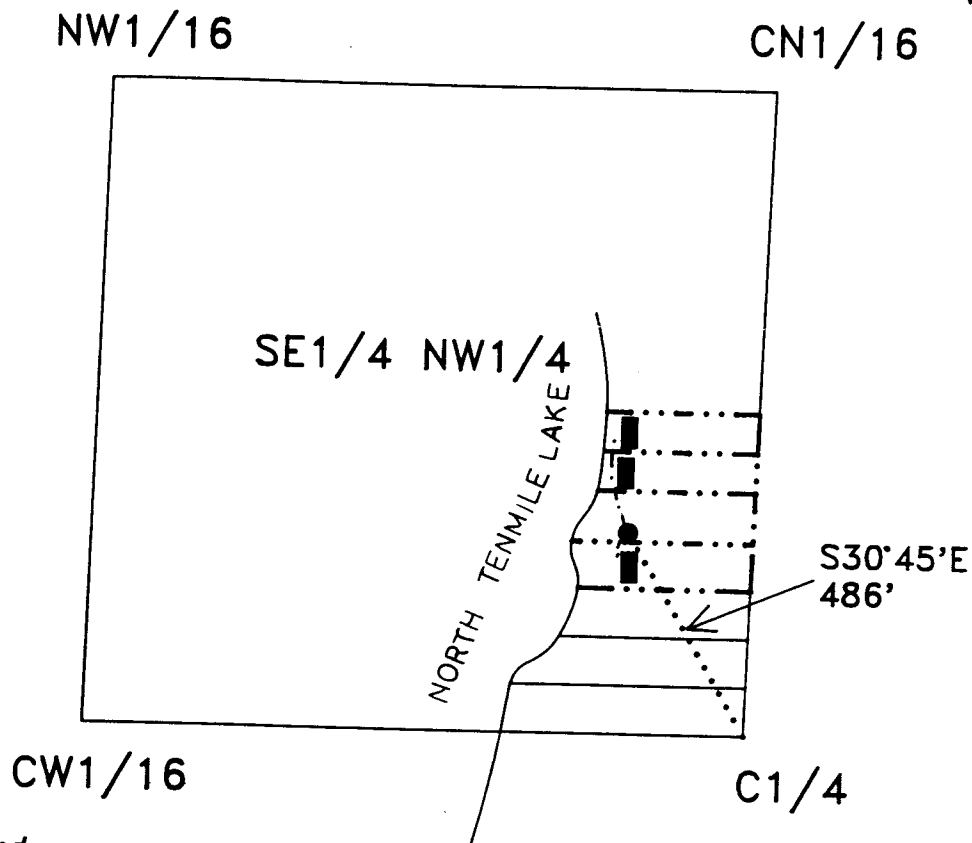


Scale 1" = 400'

Legend

- P.O.D.
- . . . Property Line
- - - - Waterline
- House

EXAMINERS DISCLAIMER STATEMENT

The preparation of this map was for the purpose of identifying the location of the Water Right only and has no intent to provide dimensions or location of property ownership lines.

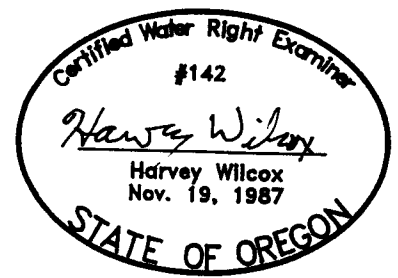

RENEWAL 6/30/98

FINAL PROOF SURVEY

IN THE NAME OF

Arnold and Louise Cullum
James Nesbit and Sherry Sorenson
James and Jytte Leonard

Application No. S-81051

Permit No. 53107