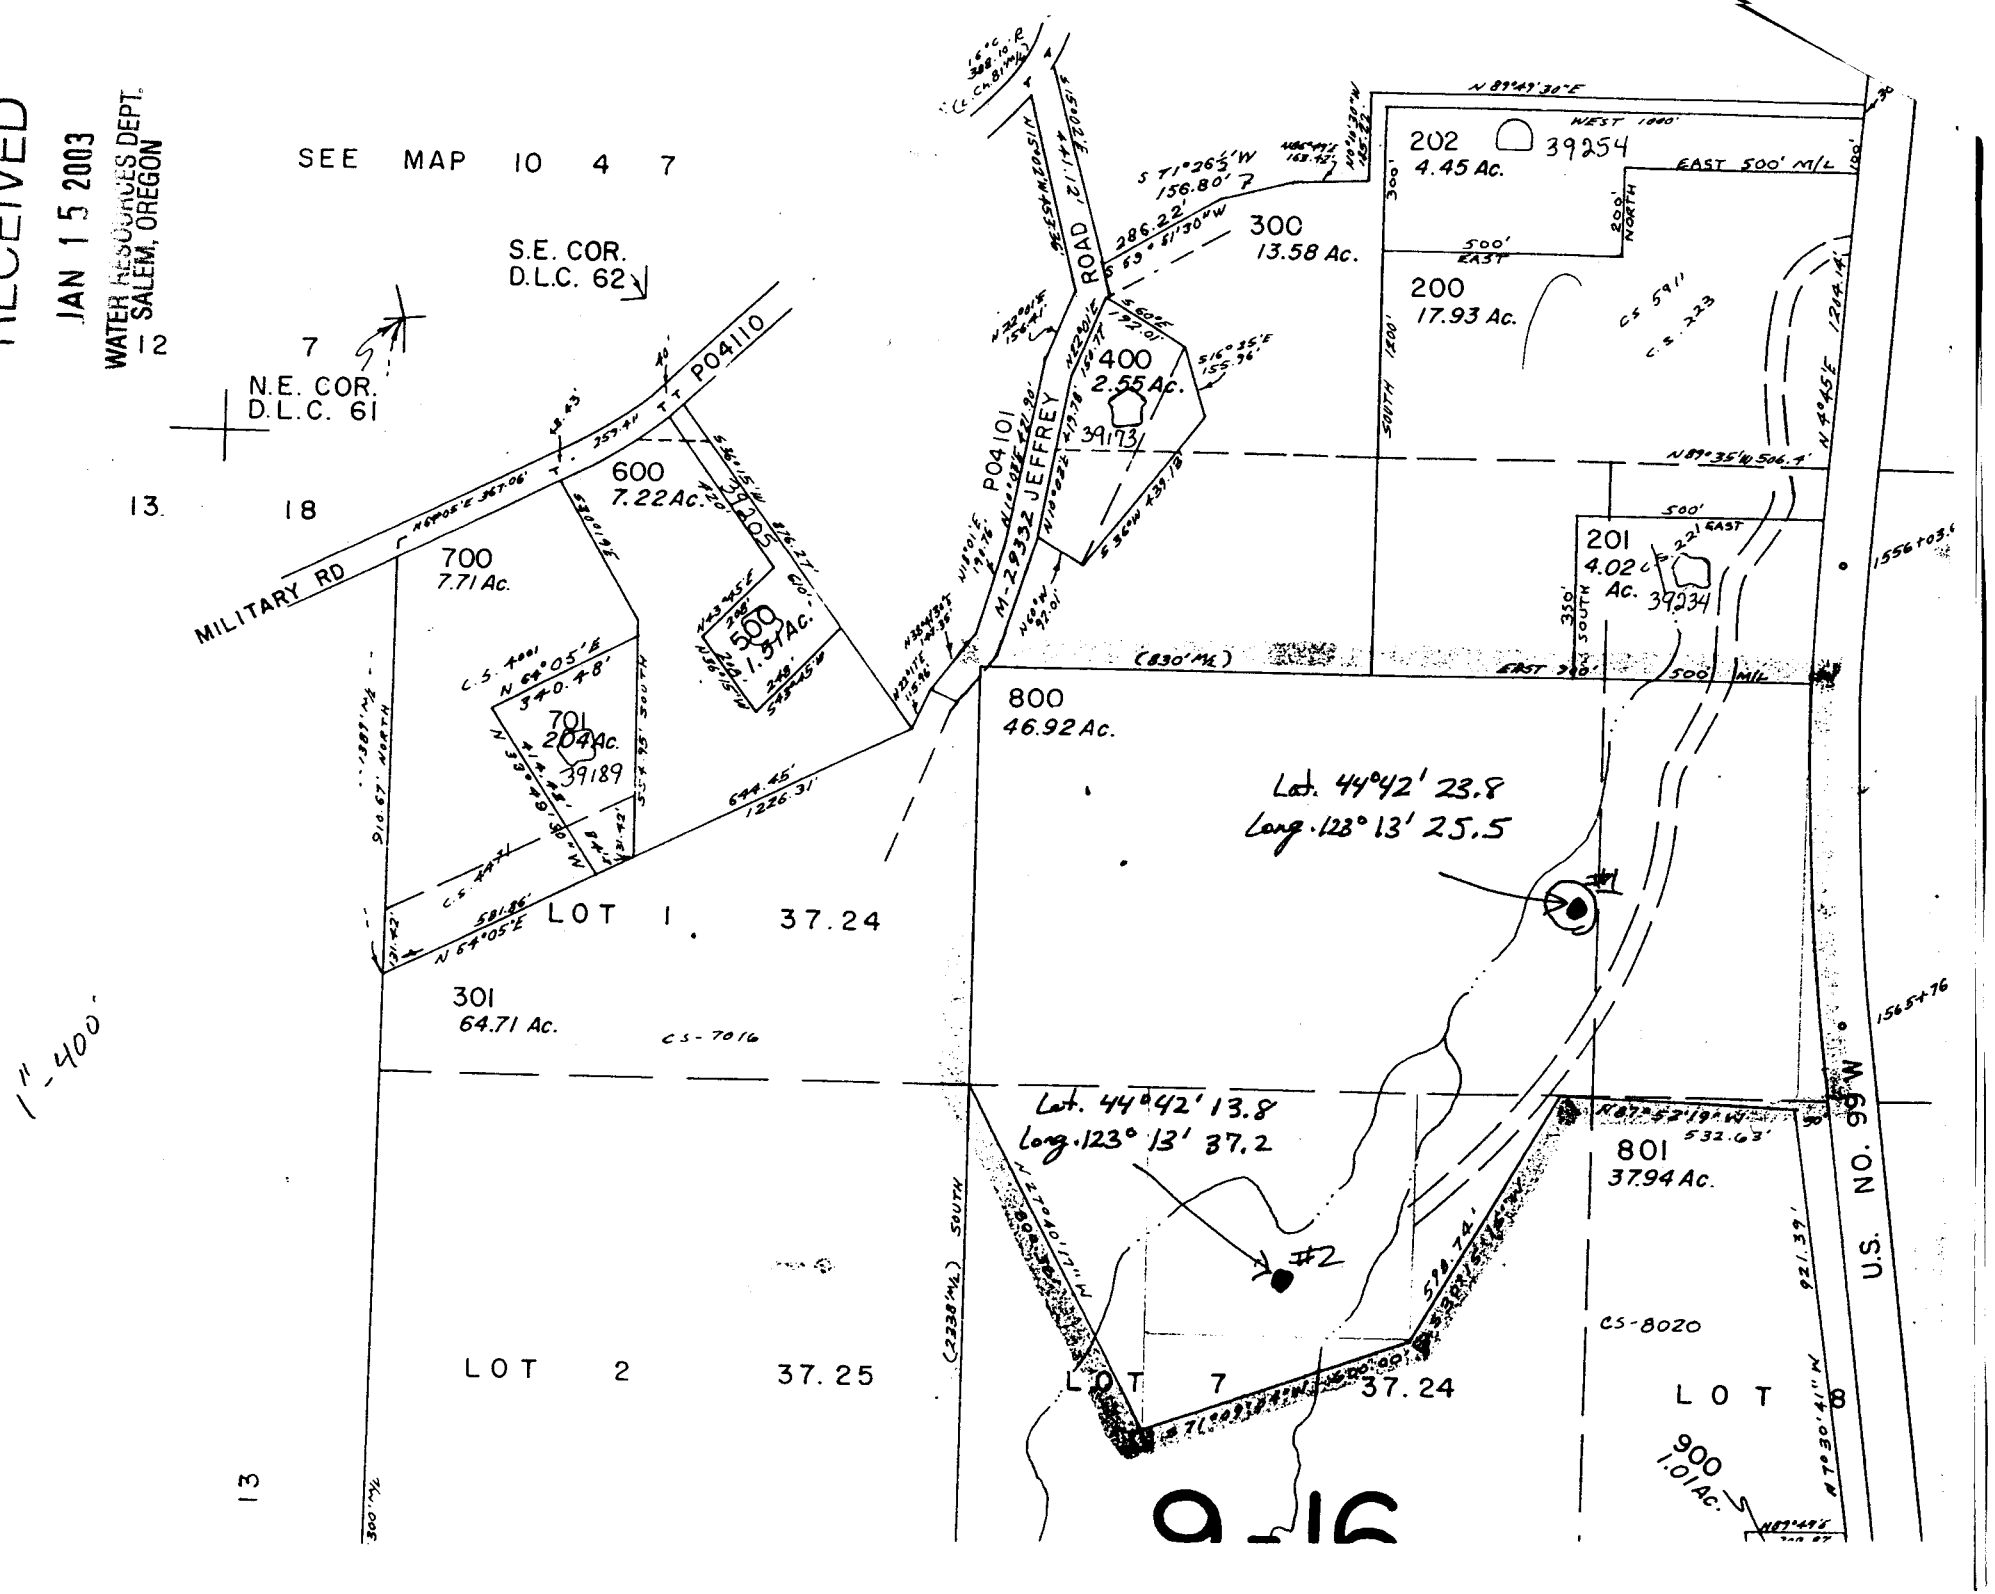RECEIVED
JAN 15 2003
WATER RESOURCES DEPT.
SALEM, OREGON