


T.1N., R.13E., W.M.

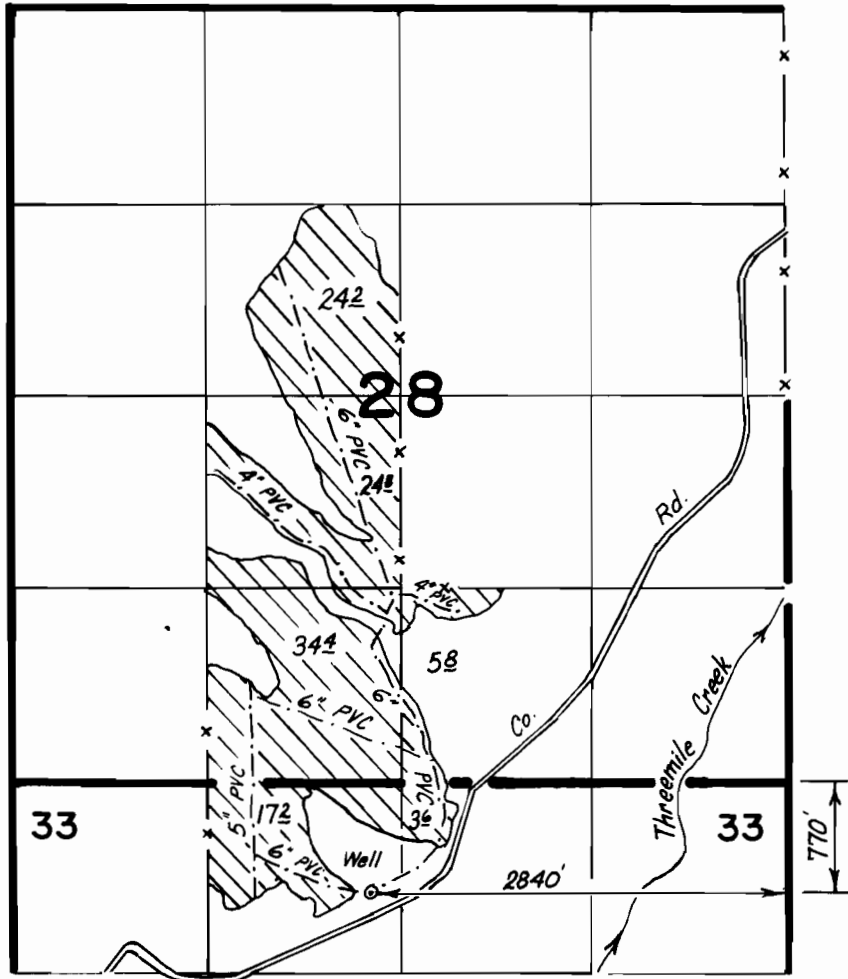


FINAL PROOF SURVEY UNDER

Application No. **G9611**... Permit No. **G8798**..
IN NAME OF

.....**ALBERT C. McCLURE**.....

Surveyed *10-16*.. 19*84*.. by *Tom Paul*.....

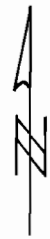

Scale: 1" = 1320'