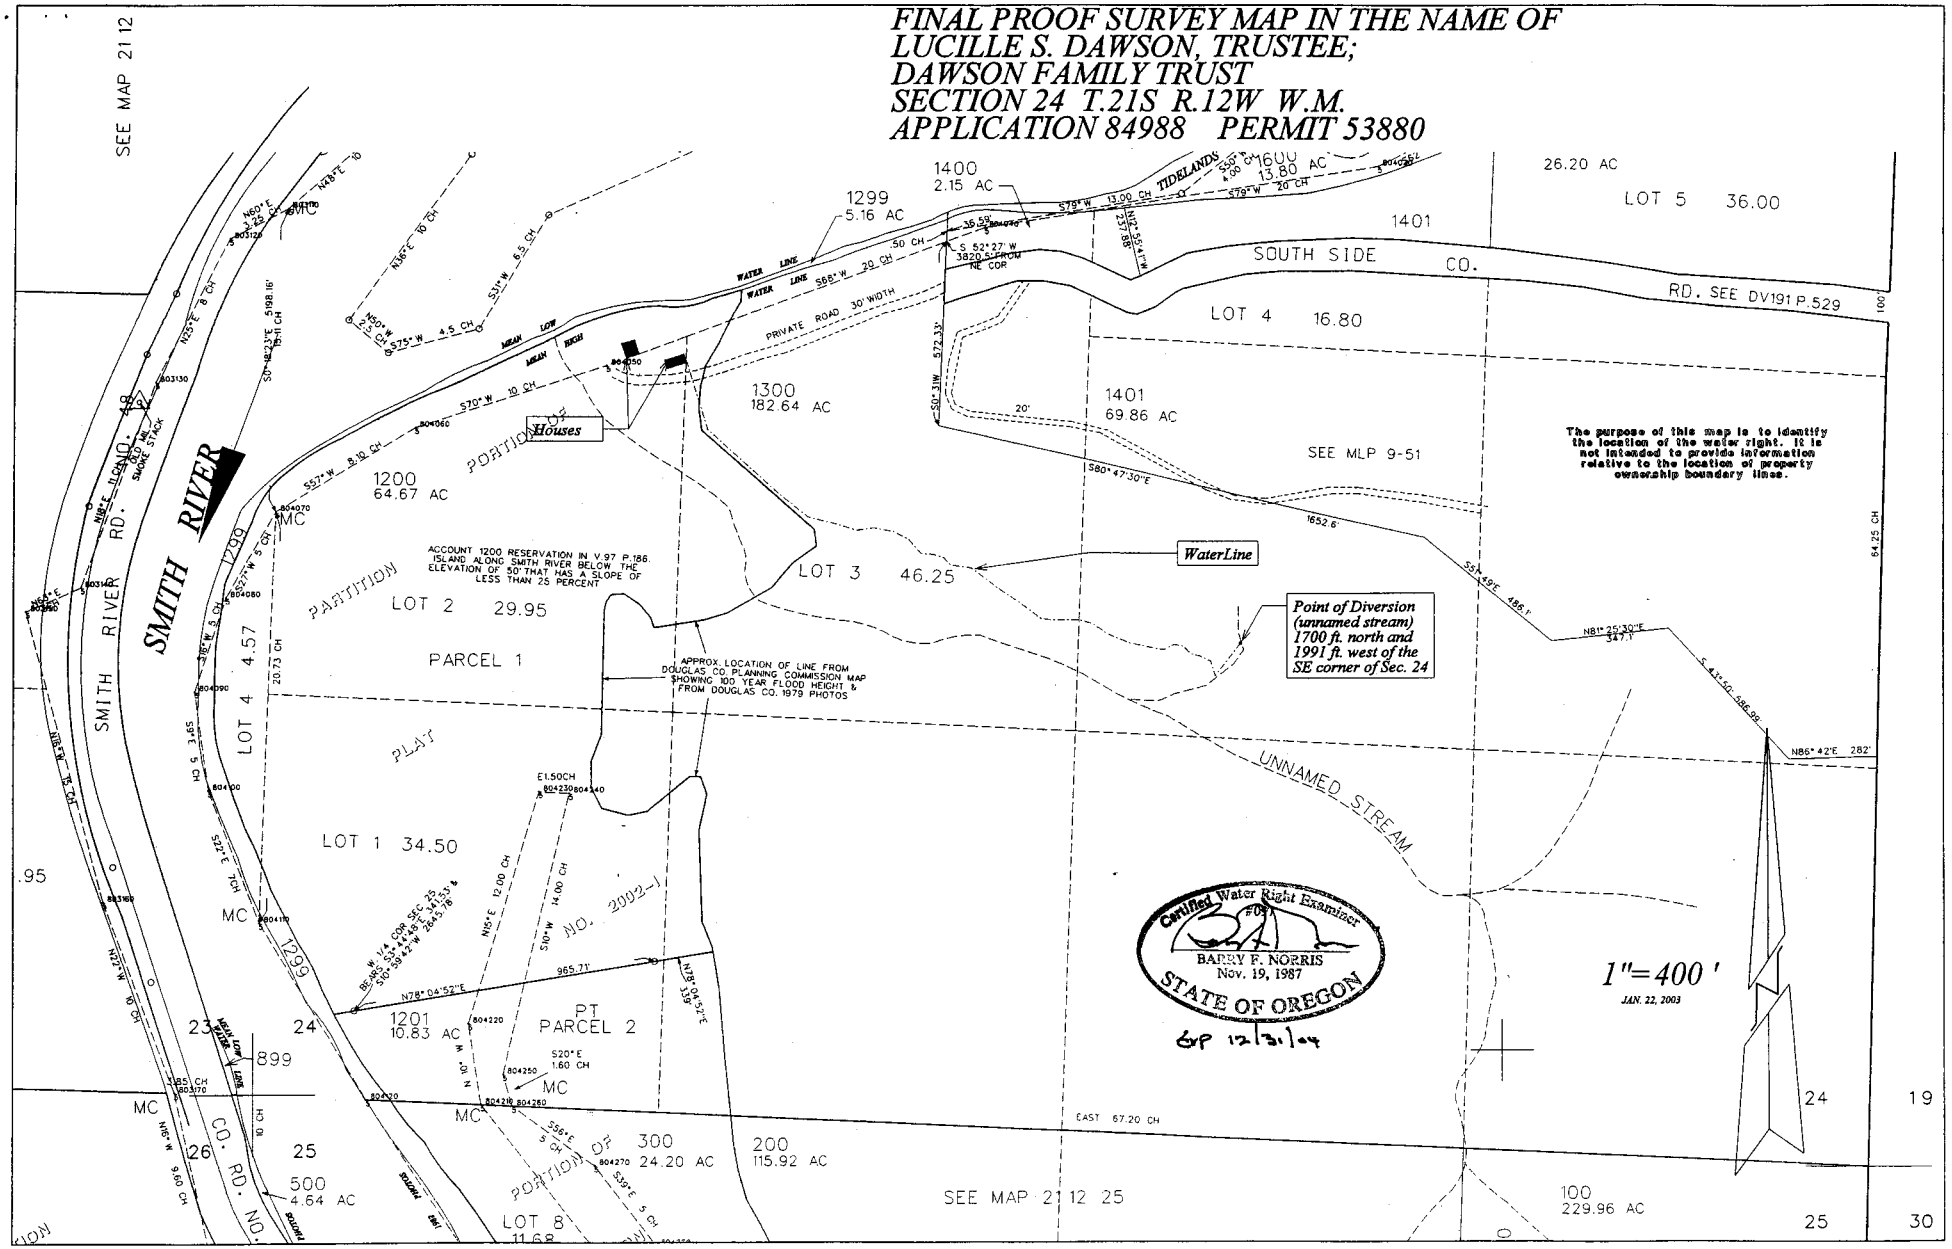FINAL PROOF SURVEY MAP IN THE NAME OF LUCILLE S. DAWSON, TRUSTEE; DAWSON FAMILY TRUST SECTION 24 T.21S R.12W W.M. APPLICATION 84988 PERMIT 53880