


T. 8 S. R. 4 W. W. M.

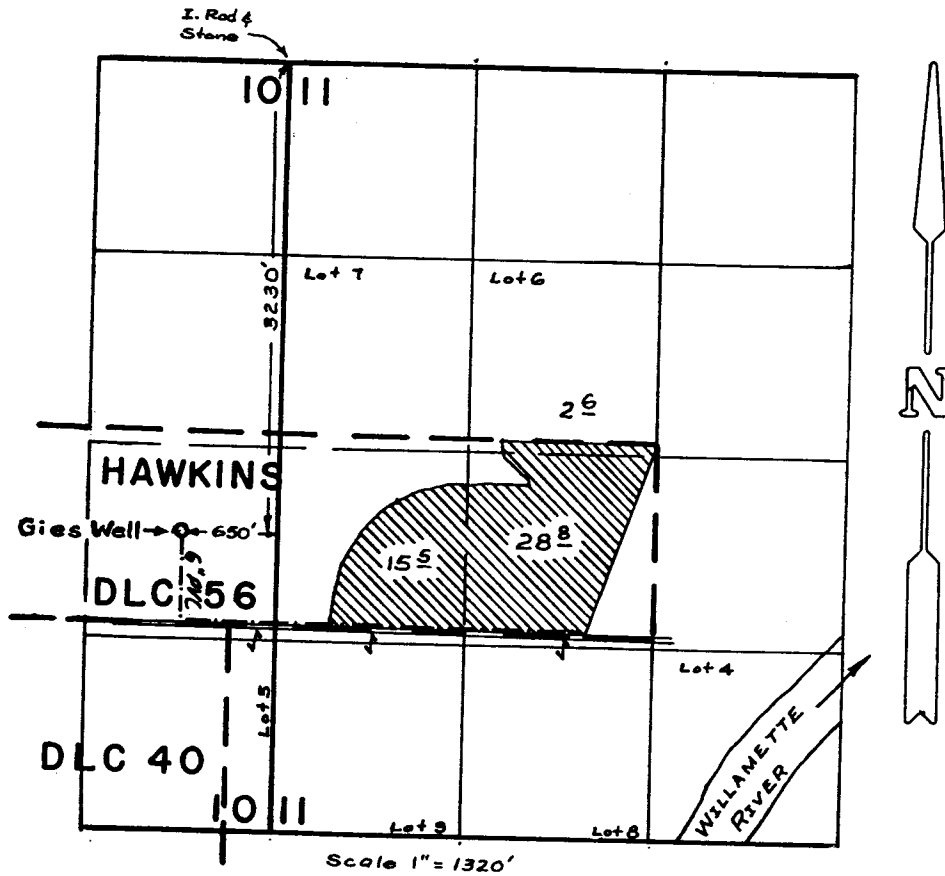

RECEIVED

AUG 19 1998


WATER RESOURCES DEPT.
SALEM, OREGON

FINAL PROOF SURVEY
UNDER

Application No. G-13559 Permit No. G-11884.
IN NAME OF

GREEN VILLA FARMS.....

Surveyed JULY.23 1998, by

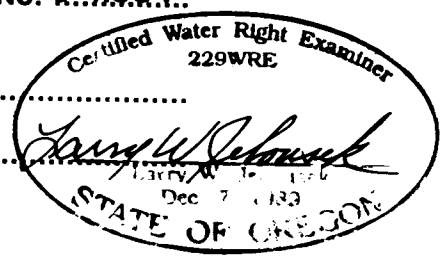

THIS MAP WAS PREPARED FOR THE PURPOSE OF IDENTIFYING THE LOCATION OF A WATER RIGHT ONLY AND IS NOT INTENDED TO PROVIDE LEGAL DIMENSIONS OR LOCATION OF PROPERTY OWNERSHIP LINES.

Inspected Bish survey of G-8709