


SCALE: 1" = 200'

UNAMEO POND
HAS EXISTED
FOR AT LEAST
30 YEARS.

STORAGE CAPACITY
0.50 A.F. ±

UNNAMED
STREAM

SEE MAP 3S 40 16

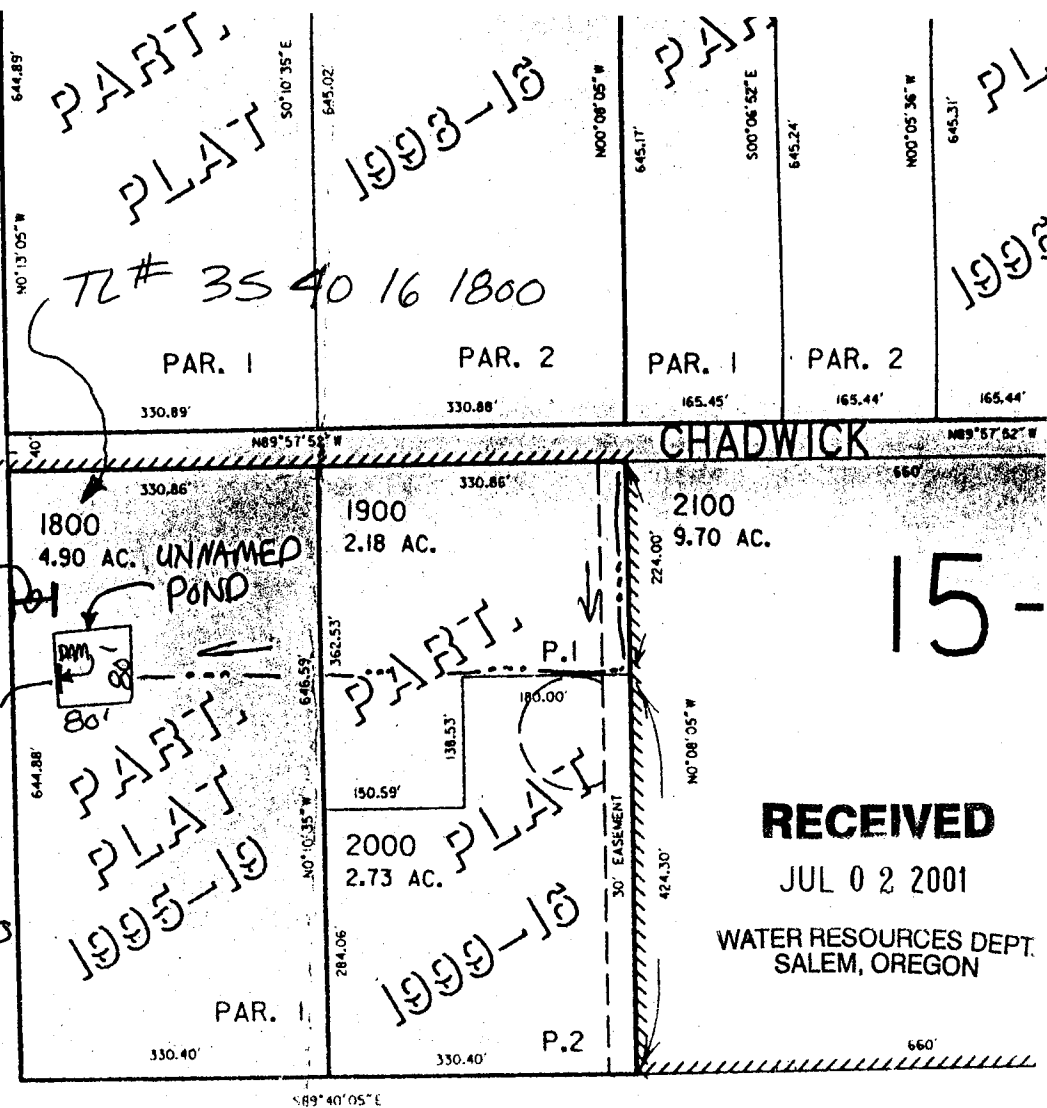

15-

RECEIVED

JUL 02 2001

WATER RESOURCES DEPT.
SALEM, OREGON

RECEIVED

JUN 11 2001

WATER RESOURCES DEPT.
SALEM, OREGON

HULICK CREEK

← = DIRECTION
OF FLOW

RECEIVED

JAN 31 2003

WATER RESOURCES DEPT.
SALEM, OREGON

DAM IS LOCATED
1080' NORTH AND
50' EAST OF CENTER 1/4
SEC. #16

T3S 40E W.M.

CEN. SEC. #16
1/4

POND IS LOCATED
WITHIN THE SW 1/4 NE 1/4
SEC. 16 T3S R.40E W.M.

MAP FOR
APPLICATION FOR A PERMIT
TO STORE WATER

MICHAEL + VALORIE POSADA

REVISED

01-25-03

06-06-01

Application No.

R-84794

Permit No.

APPLICATION # R-84794 PERMIT # R-13238